

FILED

Date: 11-18-97 By: PC

This survey consists of:

Map: _____

Narrative: _____

Corner Rpt: CS 105/15-18

OREGON CORNER RESTORATION FORM

Section 2 Township 21S Range 4W

County Douglas/Lane Date 10/10/97

**DOUGLAS COUNTY
SURVEYOR**

Corner Designation

North 1/4 corner Section 2:
(1/4 cor. between sec. 35, T20S, R4W &
sec. 2 T21S, R4W, on county line)

- Condition Report Only
- Not Found
- Renewed
- Unrecorded
- Surveyed In
- Referenced Out

Previous Renewals/Surveys, etc.

BLM Resurvey of August, 1970; also Douglas County Surveys M103-68 & M120-70

Monument(s) & Accessories Found: (Condition and Source)

Found 3 1/4" B.L.M. Brass Cap in good condition at fence corner from which:

- A 17" Fir snag bears N17°W 25.1' to face, scribing visible
- A 18" D. Fir bears N4°W 29.9' (side center measurement), healed face
- A 19" D. Fir bears N55°W 51.4' (side center measurement), healed face
- A 17" D. Fir bears S53°W 9.2' (side center measurement), healed face
- A 27" D. Fir stump bears S29°E 19.8', very rotten

Monument Detail

Sketch

The brass cap is stamped per the
BLM resurvey notes.

N/A

Monument Set (Procedures and Description)

N/A

New Accessories

No new accessories were set.

Location & Comments

The monument is located
approximately 60 feet
southeasterly of BLM road
number 20-04-35, and
approximately 300 feet
past a private gate.

Compass Declination

19°30' East

Firm/Agency

Geomax Inc.
806 N. 9th St.
Cottage Grove, OR 97424


Party Chief

Kirk F. Adkins


Notes

Job No. 97234

Surveyor's Seal

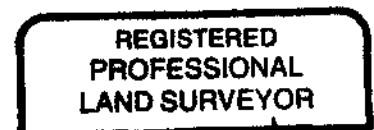

Kirk F. Adkins

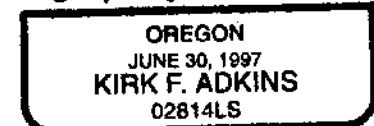

10/28/97

C.S. File No. 65/15-18