

FILED

Date: 11-18-97 By: PC

This survey consists of:

Map: \_\_\_\_\_

Narrative: \_\_\_\_\_

Corner Rpt: CS 65/15-19

**OREGON CORNER RESTORATION FORM**

Section 2 Township 21S Range 4W

County: Douglas/Lane Date: 10/10/97

**DOUGLAS COUNTY  
SURVEYOR**

**Corner Designation**

Center 1/4 corner, corner falls on  
county line

- Condition Report Only
- Not Found
- Renewed
- Unrecorded
- Surveyed In
- Referenced Out

**Previous Renewals/Surveys, etc.**

The corner was set in Douglas Co. survey number M103-68 (same as Lane Co. survey no. 27827)

**Monument(s) & Accessories Found: (Condition and Source)**

Found 1" iron pipe with yellow plastic cap stamped "Guile PLS 472" in good condition from  
which:

- A 11" D. Fir bears S63°W 18.5' (side center measurement), healed face
- A 12" D. Fir bears N40°W 20.3' (side center measurement), healed face

Both bearing trees were set in Douglas Co. survey number M103-68

**Monument Detail**

**Sketch**

See above description

N/A

**Monument Set (Procedures and Description)**

N/A

**New Accessories**

No new accessories were set.

**Location & Comments**

N/A

**Compass Declination**

19°30' East

**Firm/Agency**


Geomax Inc.  
806 N. 9th St.  
Cottage Grove, OR 97424

**Party Chief**


Kirk F. Adkins

Notes Job # 97234

**Surveyor's Seal**

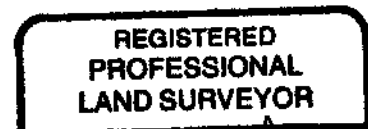

*Kirk F. Adkins*

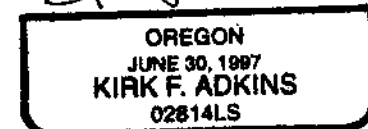

10/23/97  
G.S. File No. 65/15-19