

**OREGON CORNER RESTORATION FORM**

Section 2 Township 21S Range 4W

County: Douglas/Lane Date: 10/10/97

**FILED**  
Date: 11/18/97 By: BC  
This survey consists of:  
Map: \_\_\_\_\_  
Narrative: \_\_\_\_\_  
Corner Rpt: CS 05/15-20

**Corner Designation**

Center-North 1/16 corner (CN 1/16),  
the corner falls on the county line

**DOUGLAS COUNTY  
SURVEYOR**

- Condition Report Only
- Not Found
- Renewed
- Unrecorded
- Surveyed In
- Referenced Out

**Previous Renewals/Surveys, etc.**

See Douglas Co. survey number M103-68 (same as Lane County survey number 27827).

**Monument(s) & Accessories Found: (Condition and Source)**

N/A

**Monument Detail**

**Sketch**

N/A

N/A

**Monument Set (Procedures and Description)**

The monument set is a 5/8" x 30" iron rod with red plastic cap stamped "GEOMAX INC."  
The monument was set on the north-south centerline of Section 2 as defined by existing monuments at 20 chains proportionate measure from the center 1/4 corner (See Lane County survey file number 34709).

**New Accessories**

A 20" D. Fir bears S63°E 22.3' (side center measurement), blazed and scribed "CN 1/16 S2".  
A 13" D. Fir bears N42°E 12.1' (side center measurement), blazed and scribed CN 1/16 S2".

**Location & Comments**

N/A

**Compass Declination**

19°30' East

**Firm/Agency**

Geomax Inc.  
806 N. 9th St.  
Cottage Grove, OR 97424

**Party Chief**

Kirk F. Adkins

**Notes**


Job No. 97234

Witness: Bryan Guarina

**Surveyor's Seal**



*[Handwritten signature]*

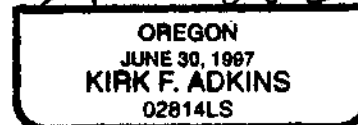

11/4/97

C.S. File No. 05/15-20