

FILED

Date: 12-10-97 By: PBC

This survey consists of:

Map: _____

Narrative: _____

Corner: CS 65/15-22

OREGON CORNER RESTORATION FORM

Section 14 Township 29S Range 4W

County Douglas Date October 12, 1997

DOUGLAS COUNTY
SURVEYOR

Corner Designation

Center 1/4 corner.

- Condition Report Only
- Not Found
- Renewed
- Unrecorded
- Surveyed In
- Referenced Out

Previous Renewals/Surveys, etc.

Set per survey M 39-21, December 1968

Referenced per survey CS 55/139-1, December 1969

Monument(s) & Accessories Found: (Condition and Source)

25" Cedar S. 16° W 47.0, good condition, per M 39-21

24" Cedar N. 47° W. 47.5, good condition, per M 39-21

Found center east 1/16, 3/4" iron pipe, S. 88° 06' 30" E. 1309.41
per M 39-21. This is basis of bearing for accessories found and set.

Note: Distances above are in feet.

Monument Detail

Sketch

Found 3/4" iron pipe in bank of creek. This monument is 1 foot from creek bank and in danger of being lost during high water.

Monument Set (Procedures and Description) NONE

Referenced County Road Dept. R/W Monument, 1.5" al. Cap on 5/8" iron rod
South 59° 16' East 64.24 feet from center 1/4 corner

Set 5/8" x 30" iron rod with 3/4" brass washer LS 866, South 88° 06' 30" East
26.56 feet from center 1/4 corner.

New Accessories

SEE ABOVE

Location & Comments

Surveyor's Seal

Compass Declination

Firm/Agency


William J. Ruppert, P. O. Box 1564, Myrtle Creek, OR 97457

Address

Party Chief W. Ruppert

Notes

Witness

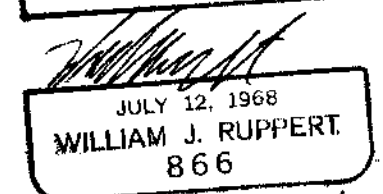

CERT. EXP. 12/31/98

C.S. File No. 65/15-22

✓540440