

FILED

Date: 8/27/97 By: BC

This survey consists of:

Map \_\_\_\_\_

Narrative: \_\_\_\_\_

Corner Rpt: CS 05/17-1

OREGON CORNER RESTORATION FORM

Section 5 Township 30S Range 8W

County Douglas Date 4/2/1997

DOUGLAS COUNTY SURVEYOR

Corner Designation

$\frac{6}{5}$   
 $\frac{7}{8}$

- Condition Report Only
- Not Found
- Renewed
- Unrecorded
- Surveyed In
- Referenced Out

Previous Renewals/Surveys, etc. #61

Monument(s) & Accessories Found: (Condition and Source)

County Surveyors Office 1 1/4 inch iron post with Brass cap  
from which an original bearing tree A Fir snag 22 inches diam, bears S. 56° E., 8 Lks dist  
Bearing Trees mkd by Vernon "Ray" Tracy, DCS, in 1965  
A chinquapin, 10" dia, B's N. 54° E., 13 Lks dist w/ healed blaze.  
A Fir, 10" dia, B's S. 18 1/4° E., 20 Lks dist. w/ healed blaze.  
A Fir, 11" diam, B's S 81 1/2° W., 8 1/2 Lks. dist. w/ healed blaze.

Monument Detail


Sketch

COUNTY SURVEYOR'S OFFICE

T 30S

$\frac{56}{55}$   
 $\frac{57}{58}$

R 8 W  
1965

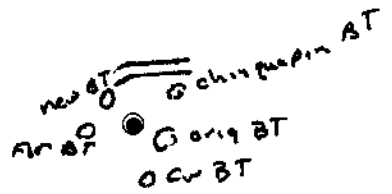

Monument Set (Procedures and Description)

\_\_\_\_\_  
 \_\_\_\_\_  
 \_\_\_\_\_

New Accessories


A Fir 12" bears N. 45 1/2° W., 6 Lks dist, mkd T30S R8W  
S 6 BT.

Location & Comments

corner is located  
20 ft south of  
Gravelled Road 20 ft  
wide BLM Rd No.  
-30-8-5.2

Compass Declination \_\_\_\_\_  
 Firm/Agency BLM  
 Address 777 NW Garden  
Valley Blvd. Roseburg  
 Party Chief Wayne Rogers  
 Notes Bryan Seibold  
 Witness John Powell

Surveyor's Seal

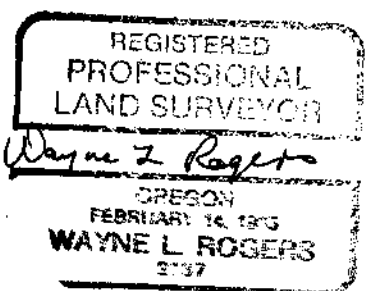

expires 12/31/98

C.S. File No. 05/17-1