


# BTS ENGINEERING AND SURVEYING, INC.

Date: 3-17-1998 By: DC  
This survey consists of:  
Map: \_\_\_\_\_  
Narrative: \_\_\_\_\_  
Corner Rpt: 65/20-8

## CERTIFIED RECORD OF LAND CORNER MONUMENTATION DOUGLAS COUNTY SURVEYOR

**History of original corner establishment:** This corner was originally established in 1931 by Otto L. Draper, U.S.G.L.O. Transitman, as follows:


- A fir, 35 ins. diam., for 1/4 sec. cor. mkd.
- 1/4 S 35 on N., and S 2 on S. side
- from which
- A fir, 24ins. diam., bears N8°E., 81 lks. dist. mkd. 1/4 S 35 B T
- A fir, 32 ins. diam., bears S.21°E., 52 lks dist., mkd. 1/4 S 2 B T

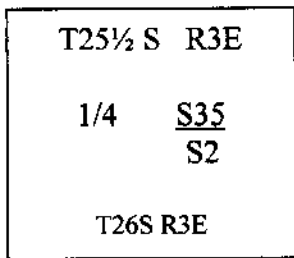

**Description of corner evidence found:** A 35" fir snag, original corner tree, ± 22 ft. tall with healed faces on the North and South sides.

- from which bearing trees by Draper in 1931:
- A 27" fir bears N.8°E., 53.5 ft. with a healed blaze.
- A 34" fir snag ± 20 ft. tall bears S.15°E., 34.0 ft. with a healed blaze.
- (Rec. S.21°E.)

**Description of monument and accessories I established to perpetuate the original location:** I establish a new reference monument and bearing tree as follows:  
A 2 ½" x 30" alum. pipe, 24" in the ground in a 48" diam. mound of stone, base to top with a 3 ¼" alum. cap stamped:

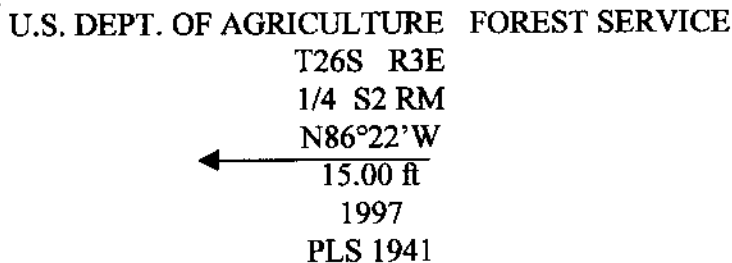

- bears S.86°22'E., 15.00 ft.
- and a new bearing tree:
- A 10" fir bears S.10°W., 18.0 ft. scribed "1/4 S2 BT" with a brass washer stamped "PLS 1941" nailed into the lower blaze.

I paint a 6" red band and BT faces red and corner tree faces red and nail USFS "BEARING TREE" and "LAND SURVEY MONUMENT" signs to all bearing trees.  
Magnetic declination: 20°E.  
Witnesses: Les Fanning, Matt Dixon, Aaron Fanning

REGISTERED  
PROFESSIONAL  
LAND SURVEYOR

OREGON  
JULY 17, 1981  
KRISTIAN O. DeGROOT  
1941

*Expire 12/31/99*

#1 T25½-3E  
#4 T26-3E  
C