

# BTS ENGINEERING AND SURVEYING, INC.

FILED

Date: 3-17-1998 By: JC

This survey consists of:

Map: \_\_\_\_\_

Narrative: \_\_\_\_\_


Corner Rpt: 65/20-10

## CERTIFIED RECORD OF LAND CORNER MONUMENTATION DOUGLAS COUNTY SURVEYOR

**History of original corner establishment:** This corner was originally established In 1929 by Otto L. Draper, U.S.G.L.O. Transitman, as follows:

Set an iron post, 3 ft. long 2 ins. diam., 27 ins. in the ground, for cor. of secs. 13, 14, 23 and 24, with brass cap mkd.

T26S | R2E  
S14 | S13  
S23 | S24  
1929

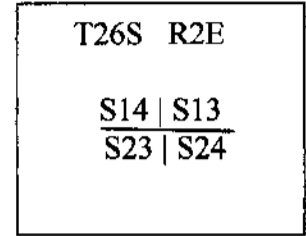

Raise a mound of stone, 5 ft. base, 3 ft. high west of cor.  
No trees within a reasonable distance.

**Description of corner evidence found:** A 2" (O.D.) iron pipe, firmly set, projecting 12' above the ground in a deteriorated mound of stone with a 2 1/2" brass cap stamped:

U.S. GENERAL LAND OFFICE  
T26S | R2E  
S14 | S13  
S23 | S24  
1929

**Description of monument and accessories I established to perpetuate the original location:** I rebuild a mound of stone, 72" diam. base to top of monument and mark new bearing trees:

- A 10" D.fir bears N.13°E., 25.0 ft. scribed "T26S R2E S13 BT"
- A 11" D.fir bears S.10°E., 19.9 ft. scribed "T26S R2E S24 BT"
- A 9" D.fir bears S.35°W., 15.4 ft. scribed "T26S R2E S23 BT"
- A 20" D.fir bears N.3°W., 35.0 ft. scribed "T26S R2E S14 BT"

I nail a brass washer stamped "PLS 1941" into the lower blaze of all bearing trees and paint a 6" red band and BT faces red and nail USFS "BEARING TREE" and "LAND SURVEY MONUMENT" signs to all BT's.

Magnetic declination: 20°E.

Witnesses: Les Fanning, Matt Dixon, Aaron Fanning

REGISTERED  
PROFESSIONAL  
LAND SURVEYOR

*Kristian D. Diegroot*

OREGON  
JULY 17, 1931  
KRISTIAN D. DIEGROOT  
1941

*Expires 12/31/99*

#65 ✓ c