


# PUBLIC LAND CORNER

INDEX NO. \_\_\_\_\_

## WEYERHAEUSER COMPANY WILLAMETTE REGION

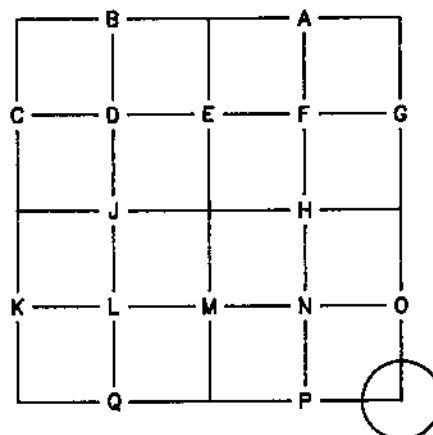

TOWNSHIP 20 S RANGE 6 W  
 SECTION 20, 21, 28, 29 CORNER SECTION CORNER  
 COUNTY LANE OREGON

ORIGINAL CORNER DATED: 1872 BY: McCLUNG  
 CORNER: POST  
 ACCESSORIES: 5" CHINQUAPIN, N 67 E, 60 LKS.; 60" FIR, N 20 W, 22 LKS.  
34" FIR, S 61 W, 35 LKS.; 55" FIR, S 51-1/4 E, 75 LKS.

REESTABLISHMENT NOTES DATED: 1950 BY: GLO  
 EVIDENCE RECOVERED: STUMP HOLE, N 65 E, 60 LKS.; 72" FIR, S 70 E, 75 LKS.  
WITH CHARRED BLAZE UNDER OVERGROWTH; 48" FIR, S 68-1/2 W, 35 LKS. WITH  
CHARRED BLAZE UNDER OVERGROWTH; ROTTEN FIR STUMP, N 5 W, 22 LKS.  
 CORNER SET: IRON POST WITH BRASS CAP DATED 1950  
 ACCESSORIES ESTABLISHED:  
14" FIR, N 56-1/2 E, 58 LKS.; 10" FIR, S 34 E, 38 LKS.  
6" FIR, S 31-1/4 W, 28 LKS.; 12" HEMLOCK, N 57 W, 26 LKS.

REESTABLISHMENT NOTES DATED: 1962 BY: GODFREY - LANE CO. RE-ESTAB #2861  
 EVIDENCE RECOVERED: 1950 GLO BRASS CAP  
FIR, S 34 E, 25.1 FT.; DEAD FIR, N 56-1/2 E, 38.2 FT. - VISIBLE SCRIBE  
DEAD FIR, S 31-1/4 W, 18.5 FT. - VISIBLE SCRIBE  
DEAD HEMLOCK SNAG, N 57 W, 17.2 FT. - VISIBLE SCRIBE  
 CORNER SET: \_\_\_\_\_  
 ACCESSORIES ESTABLISHED: 8" FIR, S 84 W, 40.2 FT.; 8" FIR, N 77 W, 7.8 FT.  
13" FIR, N 80 E, 28.0 FT.

REESTABLISHMENT NOTES DATED: \_\_\_\_\_ BY: \_\_\_\_\_  
 EVIDENCE RECOVERED: \_\_\_\_\_

CORNER SET: \_\_\_\_\_  
 ACCESSORIES ESTABLISHED: \_\_\_\_\_

### REMONUMENTATION

DATE: 3/10/98 BY: DAN BAKER TITLE: PLS 1978 FIRM: BAKER AND ASSOC.  
 EVIDENCE RECOVERED: 1950 GLO BRASS CAP  
NE BT DOWN AND OUT OF POSITION  
21" FIR, S 34 E, 25.5 FT. - CLOSED FACE 1950 GLO

CORNER SET: \_\_\_\_\_  
 ACCESSORIES ESTABLISHED:  
17" FIR, N 83 E, 14.7 FT. TO "W" NAIL - SCRIBED "T20S R6W S21 BT"  
9" FIR, S 57 W, 8.7 FT. TO "W" NAIL - SCRIBED "T20S R6W S29 BT"  
12" FIR, N 33 W, 4.8 FT. TO "W" NAIL - SCRIBED "T20S R6W S20 BT"

OTHER INFORMATION: \_\_\_\_\_  
6 FT. METAL FENCE POST 1 FT. NORTH

C.S. File No. 65/20-17A

