

OREGON CORNER RESTORATION FORM

Date: 5/5/98 By: JC

This survey consists of:

Section 1 Township 28S Range 6W
 County Douglas Date 4/15/98

Map: _____

Narrative: _____

Corner Rpt: 65/20-20

Corner Designation _____

DOUGLAS COUNTY
 SURVEYOR

- Condition Report Only
 Not Found
 Renewed
 Unrecorded
 Surveyed In
 Referenced Out


Previous Renewals/Surveys, etc. _____

Monument(s) & Accessories Found: (Condition and Source)

Found: 5/8" Iron rod 0³ feet above ground
12" OAK BEARS N48° E 25⁸ FEET (RECORD N41¹/₂° E
31¹/₂ FEET) WALL HEADS FACE AND B.T. TAG
10" OAK BEARS S42¹/₂° W 15⁹ FEET (RECORD S49¹/₂° W 16³
FEET) WALL HEADS FACE AND B.T. TAG.

Monument Detail

Sketch

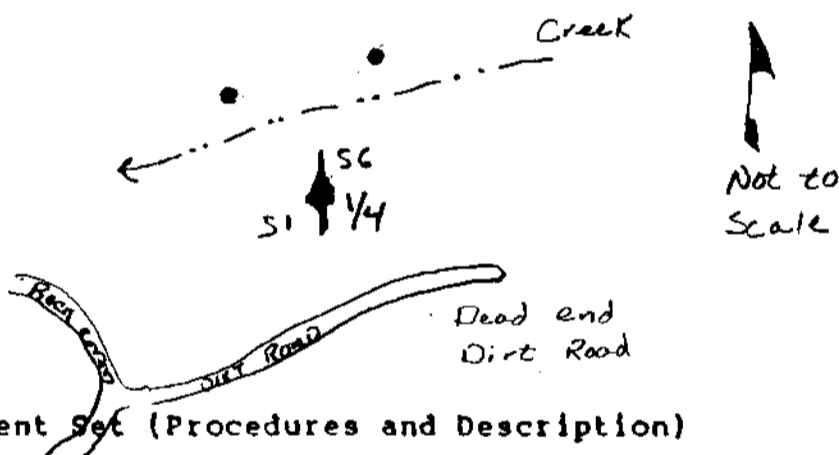

Monument Set (Procedures and Description)

New Accessories

Set: 5/8" x 36" rebar Bearing N43¹/₄° W
198¹⁰ feet from 1/4 corner
 SET: 5/8" x 36" REBAR BEARING N62³/₄° W 171[?]
FEET FROM 1/4 CORNER

Location & Comments

Surveyor's Seal

Corner lies North of 130 feet of Dirt road and south 100 feet approximately from Creek
 Compass Declination _____
 Firm/Agency Lone Rock Timber Co.
 Address Roseburg OR
 Party Chief JERRY RAGON
 Notes _____
 Witness GARY ANGIOLET

REGISTERED
 PROFESSIONAL
 LAND SURVEYOR

Ken W. Hoffine
 OREGON
 JULY 18, 1987
 KEN W. HOFFINE
 2201

6/30/99

C.S. File No. 65/20-20