

FILED

Date: 5/12/98 By: SC
This survey consists of:

OREGON CORNER RESTORATION FORM

Section 18 Township 20S Range 11W

County DOUGLAS Date 4-15-98

Corner Designation

CN 1/16

Map: _____

Narrative: _____

Corner Rpt: CS 65/20-21

DOUGLAS COUNTY
SURVEYOR

- Condition Report Only
- Not Found
- Renewed
- Unrecorded
- Surveyed In
- Referenced Out

Previous Renewals/Surveys, etc. _____

CS 51/249 - page 13

Monument(s) & Accessories Found: (Condition and Source)

3" I.P. GOOD-UNDER WATER

24" SPRUCE S2E 92⁵ - GOOD CONDITION

Monument Detail

Sketch

Monument Set (Procedures and Description)


New Accessories

BT 14" SPRUCE S12E 88⁶ SCRIBED "CN 1/16 BT"

Location & Comments

Compass Declination 10°
 Firm/Agency ROSEBURG
FOREST PRODUCTS
 Address PO Box 1088
ROSEBURG OR. 97470
 Party Chief BILL OLSON
 Notes RALPH McMANIS
 Witness _____

Surveyor's Seal

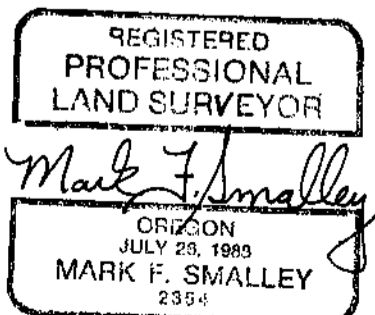

6/30/98 - Renewal

C.S. File No. 65/20-21