


BTS ENGINEERING AND SURVEYING, INC.

CERTIFIED RECORD OF LAND CORNER MONUMENTATION

History of original corner establishment: This corner was originally established in 1968 by Thomas E. Shrum under Survey M 37-17. Shrum's Corner was not accepted and the corner was reestablished in 1980 by Quimby and Ware under Survey M 79-37 for the U.S. Forest Service (Contract 53-04H1-9-7490N) as follows:

Set 2 1/2" iron pipe with brass cap marked:

T28S
R N 1/16 R
3 | S6 2
W | W
RLS 1654
1980

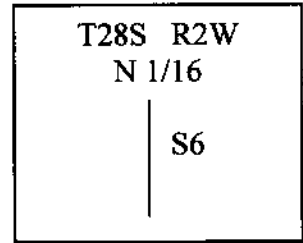

from which bears scribed new B.T.'s:
 7" D. fir S.74°W., 20.6' "N 1/16 S6 BT"
 7" D. fir N.55°W., 13.5' "N 1/16 S6 BT"
 14" D. fir S.16°E., 44.4' "N 1/16 S6 BT"
 found aluminum cap on 1" iron pipe S.15°55'44"E., 3.97'
 20" Cedar N.53°E., 18.7' vis. scribes
 7" Madrona stob S.30°E., 18.6' vis. scribes

Description of corner evidence found:

A 2 1/2" (O.D.) iron pipe, firmly set, projecting 8" above a 30" diameter mound of stone with a 2 1/2" brass cap stamped:

T28S
R N 1/16 R
3 | S6 2
W | W
RLS 1654
1980

from which bearing trees by Quimby and Ware in 1980:
 a 17" D.fir bears S.75°W., 20.8 ft. with a healed double blaze
 (Rec. S.74°W., 20.6 ft.)
 a 12" D.fir bears N.58°W. 13.3 ft. with a healed double blaze (Rec. N.55°W., 13.5 ft.)
 a 12" D.fir bears S.16°E., 40.1 ft. with illegible scribe mark visible (Rec. 44.4 ft.)
 and a monument by Shrum in 1968:
 a 1" (O.D.) iron pipe, firmly set, projecting 24" above a 24" diameter mound of stone with a 2 1/2" aluminum cap stamped "T28S R2W N 1/16 S6 RE 4287, 1968" bears S.18°E., 3.80 ft. (Rec. S.15°55'44"E., 3.97')
 and a bearing tree by Shrum in 1968 with a new tie:
 a 31" Cedar bears N.65°E., 17.1 ft. with a healed blaze (M 79-37 Rec. N.53°E., 18.7' to Shrum's monument)

Description of monument and accessories I established to perpetuate the original location:


I paint a 6" red band and BT faces red and nail USFS "BEARING TREE" and "LAND SURVEY MONUMENT" signs to all bearing trees:

Magnetic declination: 20°E.

Witnesses: Les Fanning, Matt Dixon, Aaron Fanning

FILED

Date: 6-29-1998 By: JC
 This survey consists of:
 Map: _____
 Narrative: _____
 Corner Rpt: 65/20-28

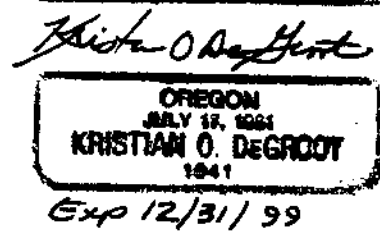

**DOUGLAS COUNTY
SURVEYOR**