

# BTS ENGINEERING AND SURVEYING, INC.

## CERTIFIED RECORD OF LAND CORNER MONUMENTATION

**History of original corner establishment:** This corner was originally established in 1911 by Morris Wygant, Compassman for Zachariah M. Derrick, U.S. Deputy Surveyor, under Contract No. 779 as follows:  
Set Hemlock Post, 3 ft. long, 4 ins. sq., 24 ins. in the ground for 1/4 sec. cor., marked 1/4 S 33 on W., and 34 on East face from which

A Fir, 10 ins. diam. bears N.47°50'E., 63 lks. dist.,  
marked 1/4 S 34 B T

A Fir, 12 ins. diam., bears S.11°50'W., 123 lks. dist.,  
marked 1/4 S 33 B T

This corner was restored by Thomas E. Shrum in 1962 but not recorded and was found by Quimby and Ware in 1980 under Survey M 79-45 for the U.S. Forest Service (Contract No. 53-04H1-9-7490N) as follows:

Fd. - 3/4" Iron pipe with aluminum cap in mound of stone mkd: "USPC PROP COR T27S R2W S33 S34 RE 4287". (NOT OF RECORD)

28" Fir bears N.48°E. 42.9 ft. with visible scribe.

38" Fir bears S.17°W., 82.3 ft. with healed blaze and "X" on tree.

T27S R2W  
1/4  
S33 | S34

### Description of corner evidence found:

A 1 1/4" (O.D.) iron pipe, firmly set, projecting 12" above a 18" high x 36" diameter mound of stone with a 2 1/2" aluminum cap stamped:

USPC PROPERTY CORNER

T27S R2W

1/4

33 | 34

RE 4287

1962

from which the original bearing trees:

a 28" sawed fir stump bears N.52°E., 42.1 ft. with scribe marks "4 BT" visible.  
(Rec. N.47°50'E, 63 lks.)

a 36" Fir bears S.17°W., 82.3 ft. with a healed blaze (Rec. S.11°50'W., 123 lks)

### Description of monument and accessories I established to perpetuate the original location:

I scribe a new bearing tree:

a 24" D. fir bears S.77°30'E., 67.2 ft., scribed "1/4 S34 BT" on a double blaze with a brass washer "PLS 1941" nailed into lower blaze.

I paint a 6" red band and BT faces red and nail USFS "BEARING TREE" and "LAND SURVEY MONUMENT" signs to all bearing trees:

Magnetic declination: 20°E.

Witnesses: Les Fanning, Matt Dixon, Aaron Fanning

FILED

Date: 6-29-1998 By: J.C.



This survey consists of:

Map: \_\_\_\_\_

Narrative: \_\_\_\_\_

Corner Rpt: 65/20-31

DOUGLAS COUNTY  
SURVEYOR

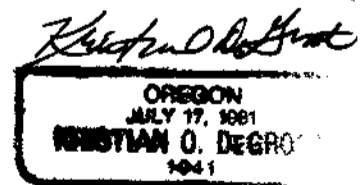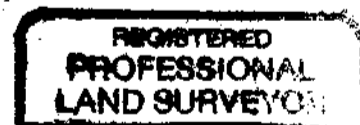

Exp 12/31/99