

FILED

Date: 10-13-1998 By: X

This survey consists of:

Map: _____

Narrative: _____

Corner Rpt: 65/20-43

OREGON CORNER RESTORATION FORM

Section 20 Township 24S Range 7W

County DOUGLAS Date 9-23-96

DOUGLAS COUNTY
SURVEYOR

Corner Designation

NW SEC COR

- Condition Report Only
- Not Found
- Renewed
- Unrecorded
- Surveyed In
- Referenced Out

Previous Renewals/Surveys, etc. _____

Monument(s) & Accessories Found: (Condition and Source)

1960 DCSD IPBC, GOOD CONDITION

23" W/FIR N5W 64³, GOOD-HEALED

44" FIR N1E 23⁸, ROTTEN


14" FIR N44E 68⁸, SNAG

10" FIR S78¹/₂E 22⁷, DOWN-ROTTEN

22" FIR S60¹/₂W 64⁹, GOOD-HEALED

Monument Detail

Sketch

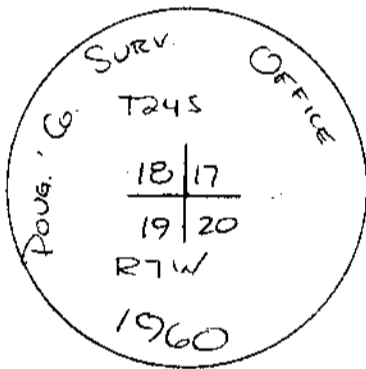

Monument Set (Procedures and Description)

New Accessories

13" FIR N28E 32³ SCRIBED "S17BT"

8" FIR S86E 34⁹ SCRIBED "S20BT"

Location & Comments

Surveyor's Seal

Compass Declination 19°

Firm/Agency ROSEBURG FOREST

PRODUCTS


Address PO Box 1088

RSBG OREGON 97470

Party Chief Bill Olson

Notes Bill Olson

Witness Ralph McManis

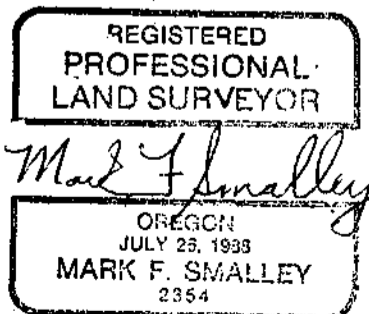

RENEWS 6/30/00

C.S. File No. 65/20-43