

FILED

Date: 10-13-1998 By: JC

This survey consists of:

Map: _____

Narrative: _____

Corner Rpt: 65/20-44

OREGON CORNER RESTORATION FORM

Section 20 Township 24S Range 7W

County DOUGLAS Date 9-23-96

DOUGLAS COUNTY
SURVEYOR

Corner Designation

NORTH $\frac{1}{4}$

- Condition Report Only
- Not Found
- Renewed
- Unrecorded
- Surveyed In
- Referenced Out

Previous Renewals/Surveys, etc. _____


Monument(s) & Accessories Found: (Condition and Source)

FOUND 1 PBC & 1 BT - GOOD CONDITION

W. OAK, 11", S $\frac{1}{2}$ ° W, 171Ks

Monument Detail

Sketch

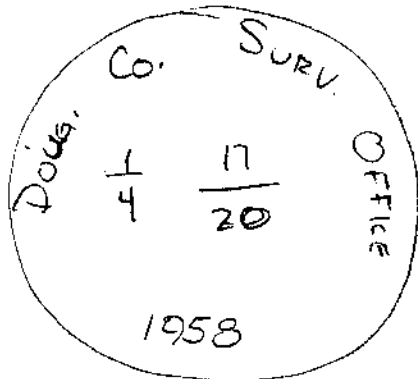

Monument Set (Procedures and Description)

New Accessories

2 Bts: OAK 9" N38E 22° SCRIBED "1/4 S 17 BT"

OAK 10" N54E 46° SCRIBED "1/4 S 17 BT"

NO OTHER TREES REASONABLY ACCESSABLE

Location & Comments

Surveyor's Seal

CORNER ON STEEP

Compass Declination 19°

E. SLOPE ABOUT 80'

Firm/Agency ROSEBURG FOREST

ELEVATION ABOVE ROAD

Products _____


Address PO Box 1088

RSBG 97470

Party Chief Bill Olson

Notes Bill Olson

Witness FELIX RADDATZ

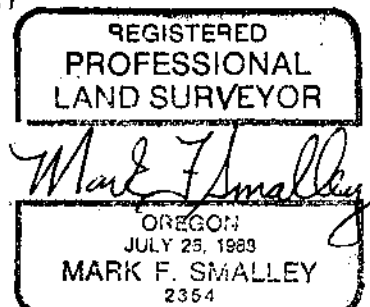

RENEW 6/30/00

C.S. File No. 65/20-44