

FILED

Date: 12-31-98 By: JC

This survey consists of:

Map: _____

Narrative: _____

Corner Rpt: 65/20-45

DOUGLAS COUNTY
SURVEYOR

OREGON CORNER RESTORATION FORM

Section 34 Township 30S Range 7W

County Douglas Date 10/20/98

Corner Designation _____


- Condition Report Only
- Not Found
- Renewed
- Unrecorded
- Surveyed In
- Referenced Out

Previous Renewals/Surveys, etc. Surveyed in 1994 By AA
RLS 1654 For Roseburg Res. (M119-21)

Monument(s) & Accessories Found: (Condition and Source)

Found Both BTS (are now stumps with open faces)
Cap + Rod had been pulled by logging. Found hole
which checked with both BTS for dist + bearing.

Monument Detail

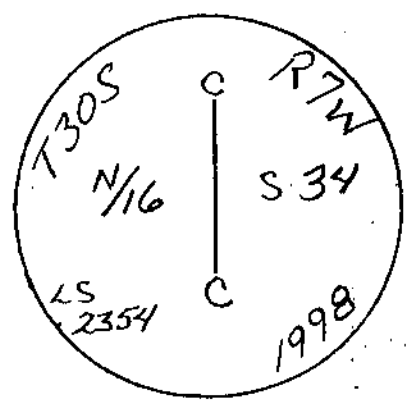

Sketch

Monument Set (Procedures and Description)

pulled from nail in BT stump with tape &
checked bearing with hand compass. Set 2" Aluminum Cap
on a 51" long rod.


New Accessories

None

Location & Comments

Compass Declination 19°
 Firm/Agency Roseburg Res.
 Address P.O. Box 1088
Roseburg, OR
 Party Chief F. White
 Notes _____
 Witness _____

Surveyor's Seal

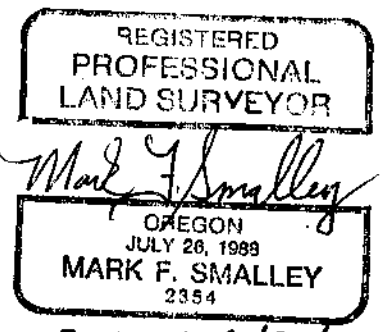

RENEWS 6/30/00

C.S. File No. 65/20-45