

FILED

Date: 1-15-1999 By: SC

This survey consists of:

Map: _____

Narrative: _____

Corner Rpt: 65/22-1

OREGON CORNER RESTORATION FORM

Section 26 Township 22S Range 9W

County DOUGLAS Date 11-16-98

Corner Designation

540200



DOUGLAS COUNTY SURVEYOR

- Condition Report Only
- Not Found
- Renewed
- Unrecorded
- Surveyed In
- Referenced Out

Previous Renewals/Surveys, etc. _____

Monument(s) & Accessories Found: (Condition and Source)

1968 DCSO IPBC

BTS: 37" FIR STUMP S2W 47^E ORIGINAL

24" CHINQUAPIN S71W 46⁷ GOOD - PARTIALLY HEALED FACE

15" FIR NSBE 37⁸ GOOD - HEALED FACE

Monument Detail

Sketch

Monument Set (Procedures and Description)

New Accessories

BTS: 9" FIR N48W 14^E SCRIBED "1/4 S BT"

11" FIR S4E 10¹ SCRIBED "1/4 S BT"

Location & Comments

Compass Declination 19°

Firm/Agency ROSEBURG

FOREST PRODUCTS

Address PO Box 1088


ROSEBURG OR. 97470

Party Chief BILL OLSON

Notes _____

Witness RALPH N^E MANIS

Surveyor's Seal

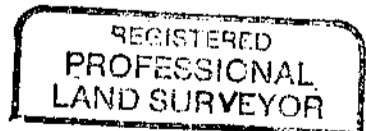

Mark F. Smalley
OREGON
JULY 26, 1938
MARK F. SMALLEY
2354

RENEWS 6/30/00