

FILED

Date: 1-15-1999 By: SC

This survey consists of:

Map: _____

Narrative: _____


Corner Rpt: 65/23-2

OREGON CORNER RESTORATION FORM

Section 26 Township 22 S Range 9 W

County Douglas Date 10-21-98

Corner Designation

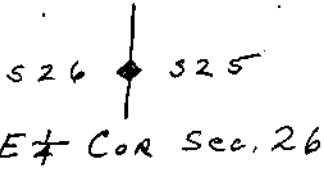

DOUGLAS COUNTY SURVEYOR

- Condition Report Only
- Not Found
- Renewed
- Unrecorded
- Surveyed In
- Referenced Out

Previous Renewals/Surveys, etc. # 600240

C.S. File # 54-60

Monument(s) & Accessories Found: (Condition and Source)

BRASS CAP "COUNTY SURVEYOR OFFICE 1968 - T22 S R9 W # S 26 | S 25."

19" FIR S51°E 49± GOOD COND. - HEALED FACE
25" FIR S11°W 64± GOOD COND. - HEALED FACE

Monument Detail

Sketch

Monument Set (Procedures and Description)

New Accessories

21" FIR N76°W 23±, SCRIBED "1/4 S BT"
17" FIR N4°E 64±, SCRIBED "1/4 S BT"

Location & Comments

Compass Declination 19°

Firm/Agency ROSEBURG FOREST PRODUCTS

Address P.O. Box 1088

Party Chief BILL OLSON

Notes _____

Witness RALPH MEMANIS

Surveyor's Seal

REGISTERED
PROFESSIONAL
LAND SURVEYOR

Mark F. Smalley

OREGON
JULY 26, 1988
MARK F. SMALLEY
2354

RENEWS 6/30/00

C.S. File No. 65/23-2