

FILED

Date: 5-21-1999 By: XC

This survey consists of:

Map: _____

Narrative: _____

Corner Pkt: 65/23-8

OREGON CORNER RESTORATION FORM

Section 34 Township 21 S Range 8 W

County DOUGLAS Date 5-7-99

DOUGLAS COUNTY
SURVEYOR

Corner Designation

WITNESS MONUMENT TO
N W SECTION CORNER.

- Condition Report Only
- Not Found
- Renewed
- Unrecorded
- Surveyed In
- Referenced Out

Previous Renewals/Surveys, etc. _____

ORIGINAL G.L.O. & 1945 DEPENDENT RESURVEY

Monument(s) & Accessories Found: (Condition and Source)

1945 BRASS CAP

48" CEDAR (1945) N. 26 1/4" E., 170 lks.

~~NEW BT: 17" DIAM. HEMLOCK~~

72" FIR N. 58 1/2" W., 222 lks.

Monument Detail

Sketch

Monument Set (Procedures and Description)

N/A

New Accessories

17" HEMLOCK SCRIBED S 34 WC BT BAS. S. 60° E., 17.94'

11" FIR SCRIBED S 33 WC BT BEARS S. 88° W., 15.13'

Location & Comments

Surveyor's Seal

Compass Declination 17 1/2° E.

Firm/Agency _____

David Edwards Land Surveying


Address P.O. Box 361

Oakland, OR, 97462

Party Chief DAE

Notes _____

Witness BM

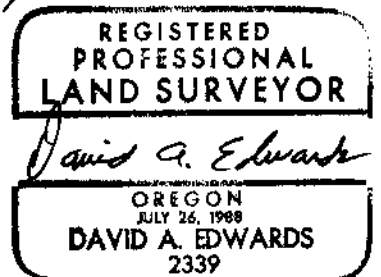

C.S. File No. 65/23-8