

FILED

Date: 11-30-1999 By: JC

This survey consists of:

Map: \_\_\_\_\_

Narrative: \_\_\_\_\_

Corner Pkt: 65/23-18

OREGON CORNER RESTORATION FORM

Section 13 Township 22S Range 6W

County Douglas Date Nov. 16, '99

DOUGLAS COUNTY SURVEYOR

Corner Designation

S11 | S12  
---+---  
S14 | S13

- Condition Report Only
- Not Found
- Renewed
- Unrecorded
- Surveyed In
- Referenced Out

Previous Renewals/Surveys, etc.

Douglas County Surveyor's Office, Feb. 13, 1968

Monument(s) & Accessories Found: (Condition and Source)

Found 2" Iron Pipe & bent 1" Iron Pipe. } from which a:  
Brass Cap gone & needs replacement. }  
24" D. Fir BT (record 8"), face over grown, bears  
N.34°E, 31 3/4 feet.  
24" P. Fir BT (record 11"), face overgrown, bears  
S50°W, 71 1/2 feet.  
Maple BT & power pole gone.

Monument Detail

Sketch

BC Needs Replacing.

Monument Set (Procedures and Description)

None.

New Accessories

None.

Location & Comments

Section Corner is  
at end of newly  
rocked road in  
BV Camp (small &  
new).  
A N-S fence  
line is East some  
50 Feet ±.

Compass Declination 20°E

Firm/Agency Shaner  
ENGINEERING


Address P.O. Box 1430  
Roseburg, Oregon 97470

Party Chief B. Shaner


Notes \_\_\_\_\_

Witness Brad Cole

Surveyor's Seal

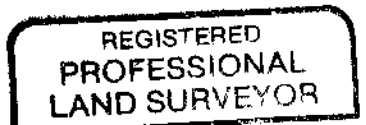

Bruce A. Shaner

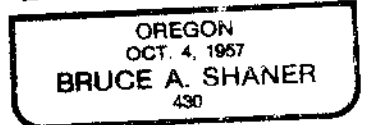

Renews June 30,  
2000

C.S. File No. 65/23-18