

FILED

Date: 11-30-1999 By: JC

This survey consists of:

Map: _____

Narrative: _____

Corner Pp: 65/23-22

OREGON CORNER RESTORATION FORM

Section 12 Township 26S Range 07W

County Douglas Date 10/25/99

DOUGLAS COUNTY
SURVEYOR

Corner Designation

- Condition Report Only
- Not Found
- Renewed
- Unrecorded
- Surveyed In
- Referenced Out

Previous Renewals/Surveys, etc. _____

Monument(s) & Accessories Found: (Condition and Source)

NE Corners Sec. 12 BC per D.C.S.O. Record in
N/S wire fence.
10" dbl W. Oak BT now 16", Brg. S28°E, 24.9' has dbl
Scar
8" W. Oak BT now 9", Brg. N16°E, 35.2' scar visible & tag
10" W. Oak BT now 14", Brg. N49°W, 44.5' dbl scar visible
and tag reattached
30" W. Oak BT now Stump 30", Brg. S8°W, 97', scar on NE.

Monument Detail

face

Sketch


Monument Set (Procedures and Description)

New Accessories

Location & Comments

Surveyor's Seal

Compass Declination 19.5'
 Firm/Agency Sweeden
Land Surveying
 Address 5211 Cole Rd
Oakland OR. 97462
 Party Chief C. Sweeden
 Notes C. Sweeden
 Witness E. Wilds

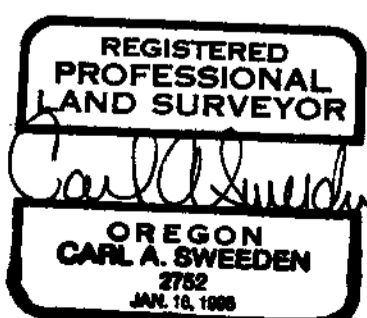

Exp. 6/30/00

C.S. File No. 65/23-22