

FILED

Date: 2-17-2000 By: JC

This survey consists of:

Map: _____

Narrative: _____

Corner Rpt: 65/30-3

OREGON CORNER RESTORATION FORM

Section 30 Township 31S Range 7W

County DOUGLAS Date 2-1-00

DOUGLAS COUNTY
SURVEYOR

Corner Designation

140200

- Condition Report Only
- Not Found
- Renewed
- Unrecorded
- Surveyed In
- Referenced Out

Previous Renewals/Surveys, etc. _____

Monument(s) & Accessories Found: (Condition and Source)

1965 D.C.S.O. I.P.B.C.

10" FIR N38E 1^B GOOD CONDITION - HEALED FACE

11" FIR S72E 38³ GOOD CONDITION - HEALED FACE

40" DOUBLE FIR S70W/38³ GOOD CONDITION. FACES CHOPPED OUT ON BOTH TREES

SCRIBE VISIBLE ON ONE FACE

Monument Detail

Sketch



Monument Set (Procedures and Description)

7" FIR S19E 19⁴ SCRIBED "1/4 S BT"

New Accessories

Location & Comments

Compass Declination 19 1/2

Firm/Agency ROSEBURG

FOREST PRODUCTS

Address PO Box 1088


ROSEBURG OR 97470

Party Chief Bill Olson

Notes _____

Witness RALPH McMAHON

Surveyor's Seal

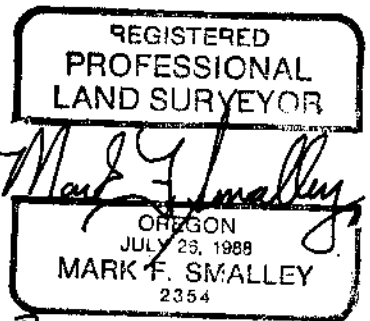

RENEWS 6-30-00

C.S. File No. 65/30-3