

**REWITNESSED CORNER FOR
STATE OF OREGON – DEPARTMENT OF FORESTRY**

South one- sixteenth corner common to Sections 7 and 8, Township 32 South, Range 6 West, W.M., Douglas County, Oregon.

ESTABLISHED by A. G. Gibson, 1974

1 1/2" x 36" galvanized iron pipe with 3" bronze cap (in place) from which a:

- 8" Fir N221/2°E 26.2 ft.; now 7" x 8' uproot, partial scribes visible.
- 11" Fir S671/2°W 41.1 ft.; now 15" in place, face closed.
- 4" x 4" x 72" white painted cedar post N45°W 2.4 ft.; missing.

REWITNESSED from the above pipe and cap:

- 48 Fir N26°W 6.3 ft. to aluminum nail in BT face bark scribed S1/16S7BT.
- Carsonite Witness Post N50°E 4.05 ft. to base
- Carsonite Witness Post S44°E 4.55 ft. to base

Oregon Department of Forestry metal location poster on 11" Fir BT S671/2°W 41.1 ft. Also bearing tree tag on 48" Fir BT N26°W 6.3 ft.

Magnetic variation set at 20° east.

Dated June 7, 2000

Rewitnessed by Tim VanVleet under my direction.

FILED

Date: 7-10-2000 By: JC

This survey consists of:


Map: _____

Narrative: _____


Corner Rpt: CS 65/30-16

DOUGLAS COUNTY
SURVEYOR

Present and witnessed by Ralph C. Hall

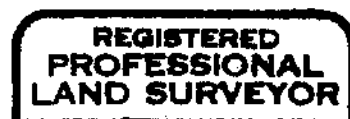

James M. McIntosh

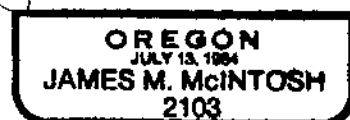

Cert. exp. 12-31-00

C.S. File No. 65/30-16