

FILED

Date: 7-20-2000 By: JP

This survey consists of:

Map: _____

Narrative: _____

Corner Rpt: CS 65/30-18

OREGON CORNER RESTORATION FORM

Section 14 Township 30S Range 9W

County DOUGLAS Date JULY 5, 2000

DOUGLAS COUNTY SURVEYOR

Corner Designation

$\frac{1}{4}$ $\frac{S14}{S23}$

- Condition Report Only
- Not Found
- Renewed
- Unrecorded
- Surveyed In
- Referenced Out

Previous Renewals/Surveys, etc.

RENEWAL #20 - HOWARD W. JOHNSTONE FOR ROSEBURG LUMBER - 9/15/61
(SEE CS 51/163)

Monument(s) & Accessories Found: (Condition and Source)


AT THE CORNER POINT I FOUND THE 1" X 30" I.P. SET BY HOWARD.
EXISTING BEARING TREES FOUND PER THE 1961 RECORD ARE AS FOLLOWS:

<u>D. FIR STUMP</u>	<u>S 66° W</u>	<u>7.9'</u>
<u>17" D. FIR</u>	<u>N 10° E</u>	<u>93.5' (NOW 21")</u>

Monument Detail

FD. 1" I.P.

Sketch

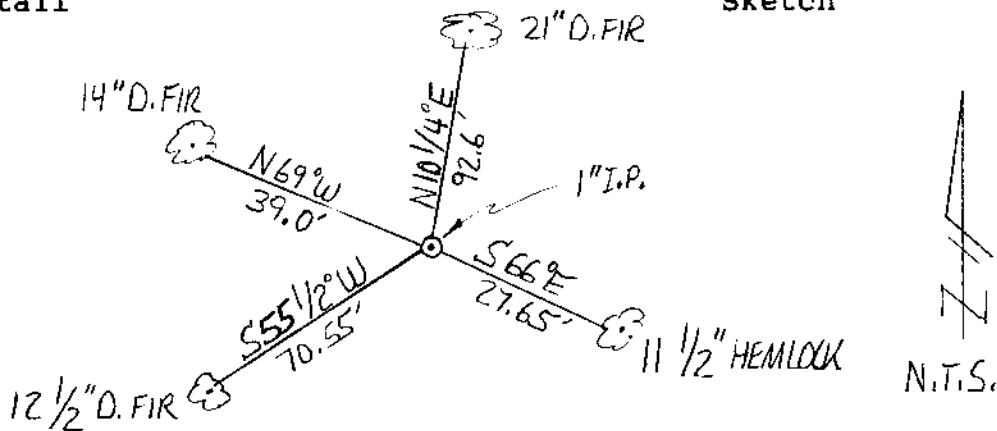

Monument Set (Procedures and Description)

NONE

New Accessories

* OUR MEASUREMENT TO PREVIOUS ACCESSORY

- 11 1/2" HEMLOCK BEARS S 66° E 27.65' FROM I.P. - SCRIBED "1/4 S 23" "BT"
- 12 1/2" D. FIR BEARS S 55 1/2° W 70.55' FROM I.P. - SCRIBED "1/4 S 23" "BT"
- 14" D. FIR BEARS N 69° W 39.0' FROM I.P. - SCRIBED "1/4 S 14" "BT"
- * 21" D. FIR BEARS N 10 1/4° E 92.6' FROM I.P. - SCRIBED "1/4 S 14" "BT"

Location & Comments

SPIKES WERE SET IN
THE SIDE & BOTTOM OF BT'S
FOR DISTANCE REFERENCE.

CORNER LIES 763' WEST OF
RIDGETOP & 50'± WESTERLY
OF WHERE A BENCH DROPS
OFF TOWARD A SMALL CREEK
TO THE WEST.

Compass Declination 18° E


Firm/Agency GREGORY D. LANG

Address 7550 WILLIS CR. RD.
WINSTON, OR. 97496

Party Chief G. LANG, T. LANG

Notes SAME
Witness DAN CLIFFORD

Surveyor's Seal

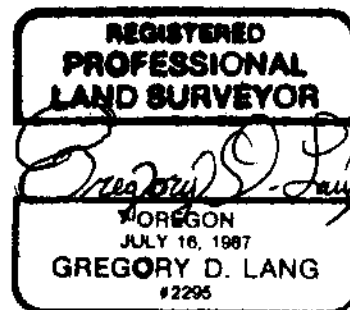

EXPIRES 12-31-00

C.S. File No. 65/30-18

C #1168