

OREGON CORNER RESTORATION FORM

Date: 8-24-2000 By: JC

This survey consists of:

Section 33, 34 Township 22S Range 8W

Map: \_\_\_\_\_

County Douglas Date 6/15/00

Narrative: \_\_\_\_\_

Corner Rpt: 65/30-20

Corner Designation

Section corner Sections 33, 34  
only T 22 S, R 8 W, W.M.

DOUGLAS COUNTY

- Condition Report Only
- Not Found
- Renewed
- Unrecorded
- Surveyed In
- Referenced Out

Previous Renewals/Surveys, etc. \_\_\_\_\_

Monument(s) & Accessories Found: (Condition and Source)

3 1/4" BLM Brass Cap

BT: 30" W. Oak bears N 22° E 35 1/2 ft healed face


BT: 23" Twin W. Oak bears N 64° E 21 1/8 ft.  
healed face

BLM CC Sections 3, 4 bears S 87° 46' E 181 3/4 ft

Monument Detail

Sketch

T 22 S R 8 W  
 S 33 | S 34  
 S 4  
 T 23 S  
 1962

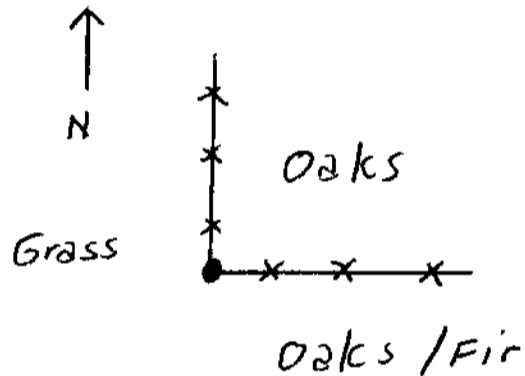

Monument Set (Procedures and Description)

None

New Accessories

None

Location & Comments

All BT's have  
red painted bands  
and faces plus  
yellow BT tags.  
Steel post set  
adjacent to  
corner.

Compass Declination \_\_\_\_\_  
 Firm/Agency Ward  
North West Inc  
 Address P O Box 105  
Florence OR 97439  
 Party Chief Rob Ward  
 Notes 00-33  
 Witness Ren Rice

Surveyor's Seal

REGISTERED  
 PROFESSIONAL  
 LAND SURVEYOR

OREGON  
 ROBERT B. WARD, JR.  
 JULY 30 1976  
 1091

expires 6/30/02

C.S. File No. 65/30-20