

FILED

Date: 8/24/2000 By: J

This survey consists of:

Map: _____

Narrative: _____

Corner Pkt: 65/30-21

OREGON CORNER RESTORATION FORM

Section 3,4 Township 23S Range 8W

County Douglas Date 6/15/00

DOUGLAS COUNTY
SURVEYOR

Corner Designation

True CC sections 3,4
T23S, R8W W.M.

- Condition Report Only
- Not Found
- Renewed
- Unrecorded
- Surveyed In
- Reference ~~Mark~~

Previous Renewals/Surveys, etc. _____

Monument(s) & Accessories Found: (Condition and Source)


3 1/4" Blm Brass Cap

BT: 39" W. Oak bears S 55 3/4° W 327 1/2 ft.
healed face

Douglas county Brass Cap bears south 1 1/2 ft

BT: 30" W. Oak bears N 14° W 24 1/2 ft healed face

Monument Detail

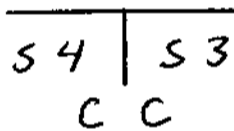


T 23S R8W
1967



Grass

Sketch

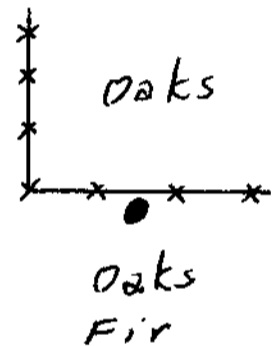

Monument Set (Procedures and Description)

None

New Accessories

BT: 16" D. Fir bears S 21° W 31 1/2 ft.
blazed and scribed T23S R8W S3 CC BT

Location & Comments

All BT's have
red painted bands
and faces plus
yellow BT tags.
steel post set
adjacent to
corner.

Compass Declination

Firm/Agency ward
Northwest Inc
Address P O Box 125
Florence OR 97439
Party Chief Rob Ward
Notes 00-33
Witness Ron Rice

Surveyor's Seal

REGISTERED
PROFESSIONAL
LAND SURVEYOR

Robert B. Ward
OREGON
ROBERT B. WARD, JR.
JULY 30, 1978
1091

expires 6/30/02

C.S. File No. 65/30-21