

FILED

Date: 11-15-2000 By: JC

This survey consists of:

Map: \_\_\_\_\_

Narrative: \_\_\_\_\_

Corner Rpt: 65/33-7

DOUGLAS COUNTY  
SURVEYOR

OREGON CORNER RESTORATION FORM

Section 24 Township 235 Range 7W

County Douglas Date Nov. 13, 2000

Corner Designation

E 1/16 513  
524

- Condition Report Only
- Not Found
- Renewed
- Unrecorded
- Surveyed In
- Referenced Out

Previous Renewals/Surveys, etc.

Pl.S. Shaner, 1962, C.S. Map M23-62.

Pl.S. Baker, 1982, " " " M93-23.

Monument(s) & Accessories Found: (Condition and Source)

Found 3/4" Iron Pipe, from which a:


24" D. Fir BT (record 16"), bears S29°E, 197 feet. (face of g.)

24" Hemlock BT (record 16") bears N40°E, 343 feet. (" ")

Steel fence post bears West, 1<sup>st</sup> feet.

Monument Detail

Sketch

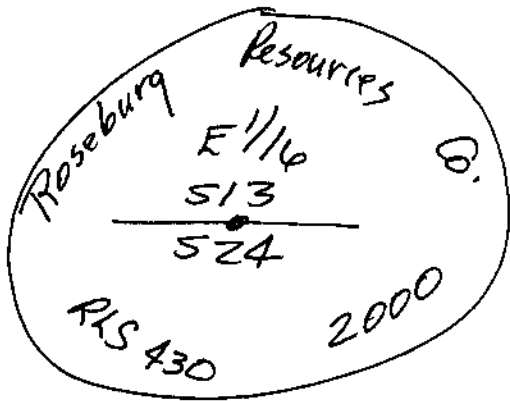

Monument Set (Procedures and Description)

I set a 3/4" x 40" Iron Rod with a 2 1/2" Alum. Cap  
over the 3/4" Iron Pipe and from which a:

New Accessories

6 foot Steel Post bears South, 1<sup>st</sup> feet.

Location & Comments

None.

Compass Declination 20°E.

Firm/Agency Shaner

Engineering, Inc.

Address RD Box 1430

Roseburg, OR 97470

Party Chief B. Shaner

Notes \_\_\_\_\_

Witness David Snyder

Ron Schneider

Surveyor's Seal

REGISTERED  
PROFESSIONAL  
LAND SURVEYOR

Bruce Shaner

OREGON  
OCT. 4, 1957  
BRUCE A. SHANER  
430

Renews June 30,  
2002

C.S. File No. 65/33-7