

FILED

Date: 11/15/2000 By: X  
This survey consists of:

Map: \_\_\_\_\_

Narrative: \_\_\_\_\_

Corner Rpt: 65/33-8

OREGON CORNER RESTORATION FORM

Section 24 Township 23S Range 7W

County Douglas Date Nov. 13, 2000

DOUGLAS COUNTY  
SURVEYOR

Corner Designation

NE 1/16

- Condition Report Only
- Not Found
- Renewed
- Unrecorded
- Surveyed In
- Referenced Out

Previous Renewals/Surveys, etc.


P.L.S. Baker, 1982, C.S. Map File M93-23.

Monument(s) & Accessories Found: (Condition and Source)

Found 1 1/2" Iron Pipe with 2 1/2" Brass Cap, from which a:  
24" D. Fir BT, face overgrown, bears N41°E, 545 feet,  
32" D. Fir BT, face " , bears S24°E, 213 "

Monument Detail

Sketch

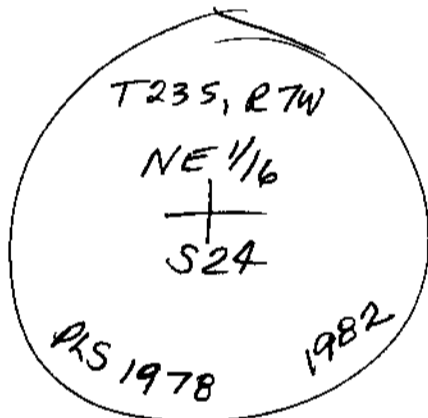

Monument Set (Procedures and Description)

None.

New Accessories

None.

Location & Comments

Compass Declination 20°E

Firm/Agency Shaner

Engineering, Inc.

Address P.O. Box 1430

Roseburg, OR 97470

Party Chief B. Shaner

Notes " "

Witness Clark McKeon

Surveyor's Seal

REGISTERED  
PROFESSIONAL  
LAND SURVEYOR

Bruce Shaner

OREGON  
OCT. 4, 1957  
BRUCE A. SHANER  
430

Renews June 30,  
2002

C.S. File No. 65/33-8