

FILED

Date: 11/15/2000 By: JC

This survey consists of:

Map: _____

Narrative: _____

Corner Rpt: 65/33-9

OREGON CORNER RESTORATION FORM

Section 24 Township 235 Range 7W

County Douglas Date Nov. 13, 2000

DOUGLAS COUNTY
SURVEYOR

Corner Designation

523 | 524
526 | 525

- Condition Report Only
- Not Found
- Renewed
- Unrecorded
- Surveyed In
- Referenced Out

Previous Renewals/Surveys, etc.

C. Kerry, P.E., 1949, C.S. File 40/190.

W. Haines, P.L.S., 1961, C.S. Map M 22-4.

Monument(s) & Accessories Found: (Condition and Source)

Found 1"x1" T Iron, from which a:

48" D. Fir BT, now a rotten stump, bears N80°E, 44³/₂ feet.


8" D. Fir BT, now gone, bears S35°E, 40¹/₂ feet.

12" D. Fir BT, now 26" stump, scribe "T" visible,
bears S40°W, 40¹/₂ feet.

14" D. Fir BT, now 28" windfall, bears N60°W, 17¹/₂ feet.

Monument Detail

Sketch

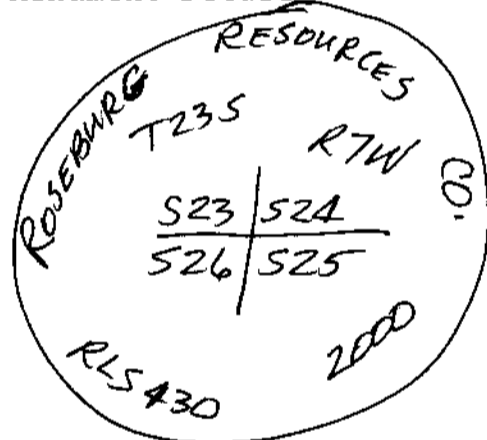

{ 2 1/2" Alum. Cap,
Set.

Monument Set (Procedures and Description)

I set a 3/4" x 40" Iron Rod with a 2 1/2" Alum. Cap over the 1"x1" T Iron, from which a:

10" D. Fir BT, I scribed "T235, R7W, 523, BT", bears N15°W, 23⁵/₂ feet

12" Yew BT, I scribed "T235, R7W, 524, BT", bears N48°E, 18¹/₂ feet.

10" D. Fir BT, I scribed "T235, R7W, 525, BT" bears S32°E, 33⁰/₂ feet.

10" D. Fir BT, I scribed " " " " 526, BT", bears S44°W, 13¹/₂ feet.

Location & Comments

Put tag on rock road, running N-S, at 150 feet West of Corner.

Compass Declination 20°E

Firm/Agency Shaner Engineering, Inc.

Address P.O. Box 1430 Roseburg Oregon 97470

Party Chief B. Shaner

Notes " "

Witness Claude McLean

Surveyor's Seal

REGISTERED
PROFESSIONAL
LAND SURVEYOR

Bruce Shaner

OREGON
OCT. 4, 1957
BRUCE A. SHANER
430

Renews June 30,
2002

C.S. File No. 65/33-9