

FILED

Date: 11/15/2000 By: X
This survey consists of:

Map: _____

Narrative: _____

Corner Rpt: 65/33-11

OREGON CORNER RESTORATION FORM

Section 24 Township 235 Range 7W

County Douglas Date Nov. 13, 2000

DOUGLAS COUNTY
SURVEYOR

Corner Designation

1/4
523 • 524

- Condition Report Only
- Not Found
- Renewed
- Unrecorded
- Surveyed In
- Referenced Out

Previous Renewals/Surveys, etc.


P.L.S. Haines, 1961, P.S. Map File M 22-4.

Monument(s) & Accessories Found: (Condition and Source)

Found 1" x 1" T Iron, from which a:
36" D. Fir BT, bark scribes visible, bears N51°W,
32± feet to center of tree.
60" Incense Cedar BT, face overgrown, bears N4°E,
12± feet to center of tree.

Monument Detail

Sketch

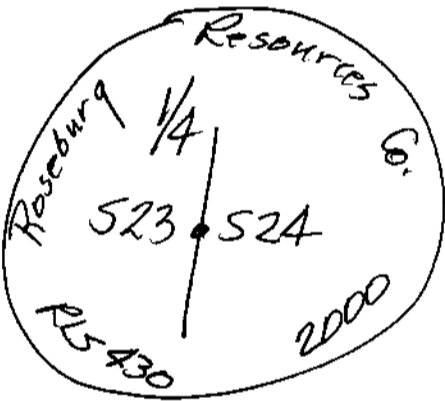

Monument Set (Procedures and Description)

I set a 2 1/2" Alum. Cap on a 3/4" x 40" Iron Rod over
the 1" x 1" T Iron, from which a:

New Accessories

6 Foot Steel Fence Post, bears North, 10 foot.
" " " " " , bears South, 10 foot.

Location & Comments

Compass Declination 20°E
 Firm/Agency Shaner
Engineering, Inc
 Address P.O. Box 1430
Roseburg, Oregon 97470
 Party Chief B. Shaner
 Notes " "
 Witness Claude McLean

Surveyor's Seal

REGISTERED
PROFESSIONAL
LAND SURVEYOR

Bruce Shaner

OREGON
OCT. 4, 1957
BRUCE A. SHANER
430

Bruce Shaner
June 30,
2002

C.S. File No. 65/33-11