

FILED

Date: 11/15/2000 By: JC

This survey consists of:

Map: _____

Narrative: _____

Corner Rpt: 65/33-14

OREGON CORNER RESTORATION FORM

Section 24 Township 23S Range 7W

County Douglas Date Nov. 13, 2000

DOUGLAS COUNTY
SURVEYOR

Corner Designation

1/4 S13
 S24

- Condition Report Only
- Not Found
- Renewed
- Unrecorded
- Surveyed In
- Referenced Out

Previous Renewals/Surveys, etc.

P.L.S. Shaner, 1962, C.S. M 23-62.


P.L.S. Baker, 1982, C.S. Map File M 93-23.

Monument(s) & Accessories Found: (Condition and Source)

Found 2" L Iron, from which a:
20" Yew BT, scribes visible, bears S50 1/2° W, 71 1/2 Feet.
10" W. Fir BT, now rotten stump, bears N65° E, 21 1/2 Feet.
6 Foot Steel Fence Post bears West, 1 1/2 feet.

Monument Detail

Sketch

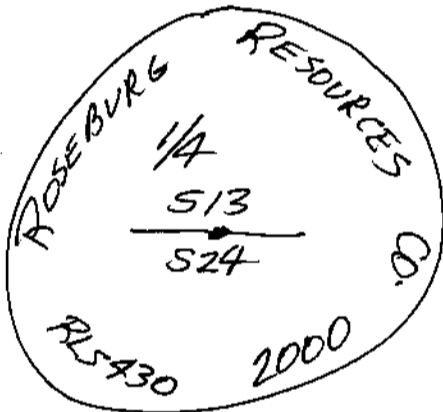

Monument Set (Procedures and Description)

I set a 2 1/2" Aluminum Cap on a 3/4" x 40" Iron Rod over
the 2" "L" Iron, from which a:

New Accessories

12" D. Fir BT, I scribed "1/4 S13 BT", bears
N6° E, 28 1/2 feet.

Location & Comments

None.

Compass Declination 20° E

Firm/Agency Shaner

Engineering, Inc.

Address P.O. Box 1430

Roseburg, OR 97470

Party Chief B. Shaner

Notes " "

Witness Ron Schneider

David Snyder

Surveyor's Seal

REGISTERED
PROFESSIONAL
LAND SURVEYOR

Bruce Shaner

OREGON
OCT. 4, 1957
BRUCE A. SHANER
490

Renews June 30,
2002

C.S. File No. 65/33-14