

OREGON CORNER RESTORATION FORM

Date: 6/6/2001 By: JC

This survey consists of:

Section 16 Township 25S Range 4W

Map: \_\_\_\_\_

County DOUGLAS COUNTY Date 4/27/01

Narrative: \_\_\_\_\_

Corner Plot: 65/37-6

Corner Designation

DOUGLAS COUNTY  
SURVEYOR

16	15
21	22

- Condition Report Only
- Not Found
- Renewed
- Unrecorded
- Surveyed In
- Referenced Out

Previous Renewals/Surveys, etc. RESET CORNER FROM EXISTING BEARING TREES RECORDED ON MAP 134-31

Monument(s) & Accessories Found: (Condition and Source)

WE FOUND THE SECTION CORNER FOR SECTIONS 15, 16, 21 & 22 TO BE UNearthED BY CAT WORK. THEREFORE WE STRAIGHTEN AND RESET 1957 BLM BRASS CAP FROM THE FOLLOWING BEARING TREES FOUND IN LRT SURVEY M-134-31

28" OAK BEARS N60 1/4° W 34.7 FEET (RECORD N60° W 34.7 FEET)



31" OAK BEARS S 31 3/4° W 34.7 FEET (RECORD S 31 3/4° W 34.7 FEET)

14" DEAD OAK BEARS N 78 3/4° E 97.2 FEET (RECORD N 78° E 97.2 FEET)

33" OAK BEARS N 35° W 85.0 FEET (RECORD N 35° W 85.0 FEET)

Monument Detail

Sketch

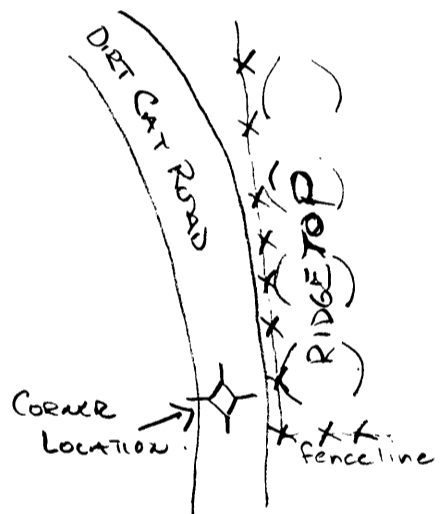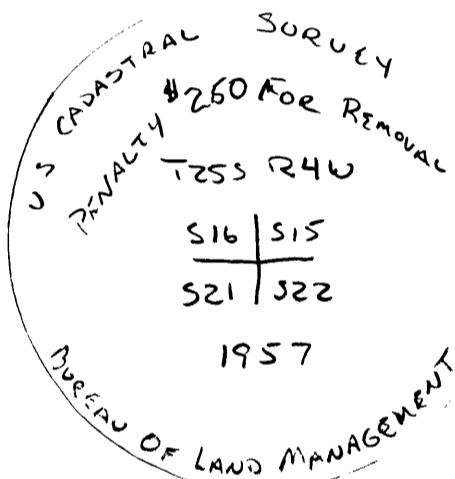

Monument Set (Procedures and Description)

IN MAP M-134-31 WE OCCUPIED THE SECTION CORNER AND TURNED TO BEARING TREES. TO RESET THE CORNER WE SET ON A POINT NEAR THE CORNER BACKSIGHT THE 31" OAK BEARING TREE AND TURNED TO THE OTHER BEARING TREES TO COMPUTE CORNER POSITION. THEN RECOMPUTE BEARING AND DISTANCES TO BEARING TREES

NOTE RESET CORNER FROM EXISTING BEARING TREES

Location & Comments

Surveyor's Seal

CORNER LIES IN EXISTING DIRT ROAD WEST OF RIDGETOP AND BURIED CAP 0.3 FT BELOW SURFACE OF THE ROAD

Compass Declination 19 1/2°  
 Firm/Agency LOWE ROCK TIMBER  
 Address P.O. BOX 1127 ROSEBURG, OR 97470  
 Party Chief KEN HOFFINE  
 Notes GARY ANGIUCCI  
 Witness MARIE DVORSEK

REGISTERED PROFESSIONAL LAND SURVEYOR

*Ken W. Hoffine*

OREGON  
JULY 16, 1987  
KEN W. HOFFINE  
2291

Expires 6-30-01

C.S. File No. 65/37-6