

OREGON CORNER RESTORATION FORM

Date: 7-6-2003 By: JC

This survey consists of:

Map: _____

Narrative: _____

Corner Rpt: 65/37-10

Section 29 Township 23S Range 5W

County DOUGLAS Date 6/22/01

Corner Designation _____

DOUGLAS COUNTY SURVEYOR

- Condition Report Only
- Not Found
- Renewed
- Unrecorded
- Surveyed In
- Referenced Out

Previous Renewals/Surveys, etc. C-N 1/16 SET by LONE ROCK TIMBER, Nov 2000, M136-28

Monument(s) & Accessories Found: (Condition and Source)

FOUND 5/8" iron rod with Alum cap missing on heavily disturbed logged ground. No fencing is present anymore and both B.T.'s are now 3 foot high stumps cut at bevel with tags and scribed faces visible


9" Doug-fir stump bears N 2 3/4° W 23.0 feet (Record 33.0)

23" Doug-fir stump bears S 69 1/2° W 45.5 feet

3' foot tall cedar post driven next to iron rod

Monument Detail

Sketch

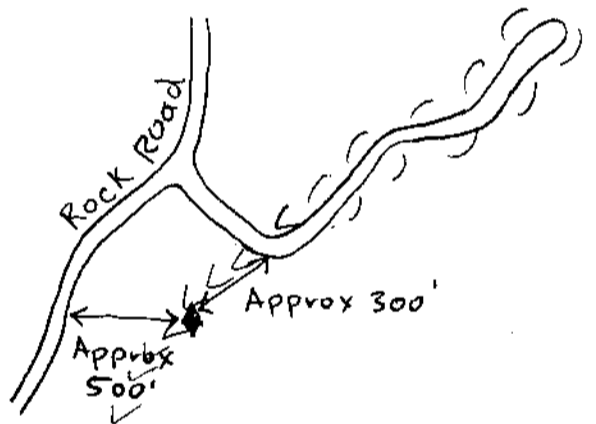

Monument Set (Procedures and Description)

NA

New Accessories

Location & Comments

new clearcut north
+ west, scrub hrdwd
To South East with
corner of Existing
Rock Road approx
300' NE.

Compass Declination 19 1/2°

Firm/Agency LONE ROCK Timber Co

Address PO Box 112

Roseburg OR

Party Chief KEN HOFFINE

Notes _____

Witness GARY ANGIOLET

Surveyor's Se

REGISTERED
 PROFESSIONAL
 LAND SURVEYOR

Ken W Hoffine

OREGON
 JULY 16, 1987
 KEN W. HOFFINE
 2291

Expires 6-30-2003

C.S. File No. 65/37-10