

FILED

Date: 7-10-2001 By: JL

This survey consists of:

Map: \_\_\_\_\_

Narrative: \_\_\_\_\_

Corner Rpt: 65/37-13



# CORNER NOTES

DOUGLAS COUNTY  
SURVEYOR

MAY 2001

BY: TONY HOSTETTER  
63538 PINTAIL DR.  
COOS BAY, OR 97420

FOR: WEYERHAEUSER COMPANY  
98674 DELLWOOD LANE  
COOS BAY, OR 97420

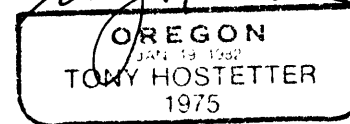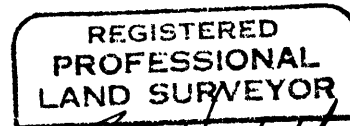

6-30-03

## **NW CORNER, SECTION 29, T. 26 S., R. 8 W., W.M.** DOUGLAS COUNTY, OREGON

FOUND: NO EVIDENCE OF 1972 BLM BRASS CAP OR BEARING TREES DESCRIBED ON PAGES 14868-69 OF DOUGLAS COUNTY SURVEYORS RECORDS. HOWEVER, BLAZED LINES WERE FOUND IN FOUR DIRECTIONS FROM THIS CORNER AND USED TO ESTABLISH APPROXIMATE LOCATION OF 1972 MONUMENT. (NOTE: THIS AREA HAS BEEN SUBJECT TO LANDSLIDE AND FLOOD DAMAGE) FROM THIS APPROXIMATE POINT, A STEEL FENCE POST WAS FOUND BURIED LYING HORIZONTALLY @ N 70°W, 8 FEET AWAY. THERE IS ALSO A LARGE ROCK @ N 60°E, 24 FEET MORE OR LESS BURIED UNDER SEVERAL LARGE LOGS WHICH MAY BE THE ORIGINAL BEARING OBJECT DESCRIBED BY THE BLM IN 1972. THE ¼ CORNER BETWEEN SECTIONS 20 AND 29 MEASURED BY 1972 BLM RETRACEMENT SURVEY TO BE 40.40 CH (2666.40 FEET), N 88° 45' W FROM THIS SECTION CORNER, WAS FOUND TO BE 2664.92 FEET FROM THE APPROXIMATE CORNER POSITION (AS MEASURED BY TOTAL STATION TRAVERSE).

IN ORDER PRESERVE THIS APPROXIMATE LOCATION, WHICH MAY BE THE BEST AVAILABLE EVIDENCE OF AN ORIGINAL CORNER POSITION, THE FOLLOWING BTS WERE ESTABLISHED:

20" ALDER, BARK SCRIBED "S21 SW BT", WEYCO TAG, BEARS; N 08° E, 29.4 FEET TO SPIKE PLACED IN ROOT COLLAR BELOW SCRIBING.

22" ALDER, BARK SCRIBED "S21 SW BT", WEYCO TAG, BEARS: N 20°E, 48.3 FEET TO SPIKE PLACED IN ROOT COLLAR BELOW SCRIBING.

"X" MARKED IN SANDSTONE BLUFF, BEARS: S 70° W, 22.7 FEET.

C.S. File No. 65/37-13