

FILED

Date: 8-2-01 By: JP

This survey consists of:

Map: M 138-46

Narrative: _____

Corner Rpt: CS 65/37-14 E


OREGON CORNER RESTORATION FORM

Section 8 Township 28S Range 3W

County DOUGLAS Date 7-31-01

DOUGLAS COUNTY SURVEYOR

Corner Designation

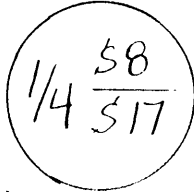

- Condition Report Only
- Not Found
- Renewed
- Unrecorded
- Surveyed In
- Referenced Out

Previous Renewals/Surveys, etc.

ORIGINAL BY GIBB IN 1910; PERPETUATED BY BYRON IN 1962
(C.S. 52/126)

Monument(s) & Accessories Found: (Condition and Source)

FOUND B. CAP SET BY BYRON, LOOSE & LEANING, BUT STILL FIRMLY IN THE
GROUND AT THE BASE. WE STRAIGHTEN & TIGHTEN; BUILD ROCK MOUND


* THE ORIGINAL NE BT (NOW 14" HEMLOCK) BEARS N 13 1/4° E 5.6 FT.

ALSO FOUND BYRON'S SE B.T. - DOWN-ROOT HOLE MATCHES CAP POSITION

Monument Detail



Sketch

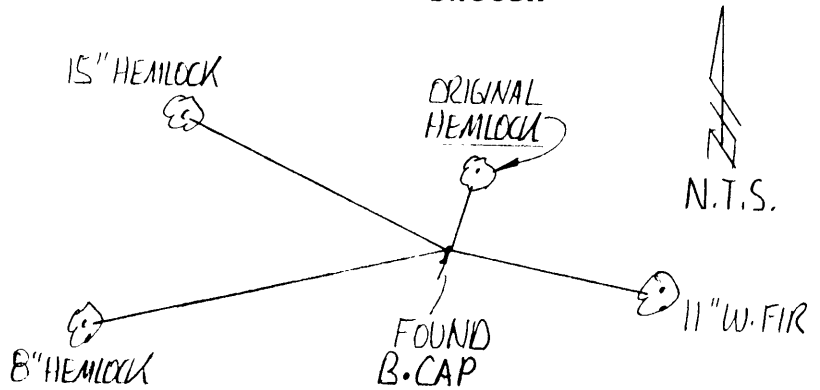

Monument Set (Procedures and Description)

N/A
SET ALUMINUM POST ALONGSIDE THE CORNER

New Accessories

- * 11" W. FIR BEARS S 81 1/4° E 14.8 FT. SCRIBED "1/4 517" BT"
- * 8" HEMLOCK BEARS S 76° W 32.2 FT. SCRIBED "1/4 517" BT"
- * 15" HEMLOCK BEARS N 58° W 24.8 FT. SCRIBED "1/4 58" BT"

* SET SPIKE IN THE BASE OF THE TREE & PLACED NEW TAG

Location & Comments

CORNER LIES @ THE FOOT OF
A NORTHWESTERLY SLOPE
& APPROX. 30' WEST OF
A SMALL CREEK.

Compass Declination N/A

Firm/Agency MOUNTAIN TOP LAND SURVEYING

Address 7550 WILLIS CR. RD.
WINSTON, OREGON 97496

Party Chief G. LANG

Notes _____

Witness T. LANG

Surveyor's Seal

