

FILED

Date: 9-14-2001 By: JC

This survey consists of:

Map: \_\_\_\_\_

Narrative: \_\_\_\_\_

Corner Rpt: 65/37-16

OREGON CORNER RESTORATION FORM

Section 4 Township 31S Range 4W

County DOUGLAS Date 9-7-01

DOUGLAS COUNTY  
SURVEYOR

Corner Designation

340600

$\frac{1}{4} \frac{4}{9}$

- Condition Report Only
- Not Found
- Renewed
- Unrecorded
- Surveyed In
- Referenced Out

Previous Renewals/Surveys, etc. \_\_\_\_\_

Monument(s) & Accessories Found: (Condition and Source)

1985 BLM IPBC

1976 DCSO IPBC N 35° E, 20°

2-3/4" I.Pipes, next to DCSO IPBC

21" FIR S44E 30' GOOD CONDITION HEALED FACE

17" FIR N20 3/4 W 21' GOOD CONDITION HEALED FACE

Monument Detail

Sketch

Monument Set (Procedures and Description)

New Accessories

10" FIR S56E 25' SCRIBED "1/4 S BT"

9" FIR N50W 16' SCRIBED "1/4 S BT"

Location & Comments

Compass Declination 20°

Firm/Agency ROSEBURG

FOREST PRODUCTS

Address PO Box 1088


ROSEBURG OR 97470

Party Chief Bill Olson

Notes \_\_\_\_\_

Witness \_\_\_\_\_

Surveyor's Seal

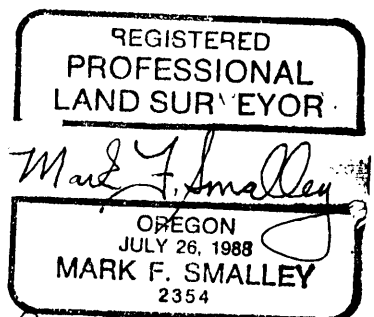

Renew 6/30/02

C.S. File No. 65/37-16