

FILED

Date: 9-14-2001 By: JC

This survey consists of:

Map: \_\_\_\_\_

Narrative: \_\_\_\_\_

Corner Rpt: 65/37-19

OREGON CORNER RESTORATION FORM

Section 14 Township 31S Range 8W

County DOUGLAS Date 5-30-01

DOUGLAS COUNTY  
SURVEYOR

Corner Designation

S.E SECTION CORNER

- Condition Report Only
- Not Found
- Renewed
- Unrecorded
- Surveyed In
- Referenced Out

Previous Renewals/Surveys, etc. \_\_\_\_\_


M 47-60, M 65-49

Monument(s) & Accessories Found: (Condition and Source)

1977 BLM Brass Cap on Iron Pipe  
18" Fir Now 24" N 50°W 10.5' Healed  
7" Fir Now 13" S 53°W 30.3' Healed  
Aluminum Cap S 29 3/4° E 13.2'  
18" Fir N 20° E 23.0' Snag

Monument Detail

Sketch

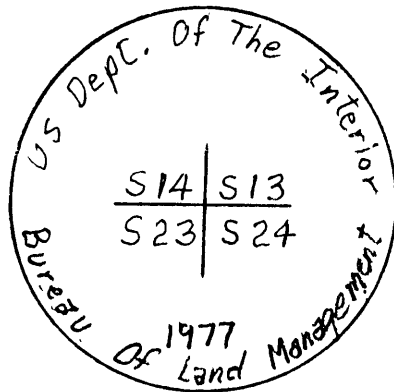

Monument Set (Procedures and Description)

New Accessories

20" Fir S 18° E 3.6' Scribed "S 24 BT"  
21" Fir S 86° W 14.1' Scribed "S 23 BT"

Location & Comments

Compass Declination 20°

Firm/Agency Roseburg

Forest Products

Address P.O. Box 1088

Roseburg, OR 97470

Party Chief Bill Olson

Notes \_\_\_\_\_

Witness Ralph McManis

Surveyor's Seal



Renews 6/30/02

C.S. File No. 65/37-19