

FILED

Date: 10-24-2001 By: JC

This survey consists of:

Map: _____

Narrative: _____

Corner Rpt: 65/37-26

OREGON CORNER RESTORATION FORM

Section 14 Township 31S Range 8W

County DOUGLAS Date 2-28-01

DOUGLAS COUNTY
SURVEYOR

Corner Designation

1/4 CORNER 15/14

- Condition Report Only
- Not Found
- Renewed
- Unrecorded
- Surveyed In
- Referenced Out

Previous Renewals/Surveys, etc.

BLM LINE NOTES - pg 13194

Monument(s) & Accessories Found: (Condition and Source)

1962 BLM I.P.B.C.

35" FIR S75E 13^z GOOD CONDITION - FACE HAD BEEN CHOPPED OUT AND GROWN OVER (RECORD 1977-40", ORIG 11^z FT)

20" FIR N25W 47^z GOOD CONDITION - FACE HAD BEEN CHOPPED OUT AND GROWN OVER

BOTH BTS: WERE MEASURED TWICE TO VERIFY THE 35" BT AND THE 20"

Monument Detail

Sketch

Monument Set (Procedures and Description)

New Accessories

Bts:

11" LIVE OAK N38W 11^o SCRIBED "1/4 S BT"

8" LIVE OAK S26E 25^z SCRIBED "1/4 S BT"

Location & Comments

Surveyor's Seal

Compass Declination 20^o

Firm/Agency ROSEBURG

FOREST PRODUCTS


Address PO Box 1088

ROSEBURG OREGON

Party Chief BILL OLSON

Notes BILL OLSON

Witness RALPH McNAMIS

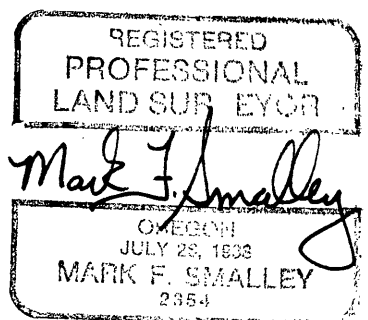

Renews 6/30/02

C.S. File No. 65/37-26