

FILED

Date: 10-24-2001 By: SC

This survey consists of:

Map: \_\_\_\_\_

Narrative: \_\_\_\_\_

Corner Rpt: 65/37-28

OREGON CORNER RESTORATION FORM

Section 16 Township 31S Range 4W

County DOUGLAS Date 3-29-00

Corner Designation

400440

S16 | S15

DOUGLAS COUNTY  
SURVEYOR

- Condition Report Only
- Not Found
- Renewed
- Unrecorded
- Surveyed In
- Referenced Out

Previous Renewals/Surveys, etc. \_\_\_\_\_

Monument(s) & Accessories Found: (Condition and Source)


1985 BLM (PBC) FIRM IN GROUND

1985 23" HEMLOCK N52W 53' GOOD - SCRIBE VISIBLE

1985 12" HEMLOCK S52 3/4 E 22' GOOD - SCRIBE VISIBLE

Monument Detail

Sketch

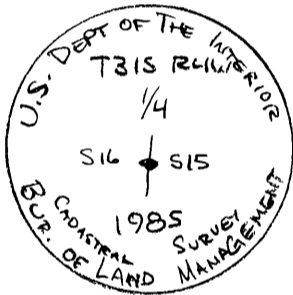

Monument Set (Procedures and Description)

New Accessories

2001 10" HEMLOCK S87E 47' SCRIBED "1/4 S BT"

2001 18" HEMLOCK S72E 56' SCRIBED "1/4 S BT"

Location & Comments

Surveyor's Seal

Compass Declination 20°E

Firm/Agency ROSEBURG

FOREST PRODUCTS


Address PO BOX 1088

ROSEBURG, OR 97470

Party Chief Bill Olson

Notes \_\_\_\_\_

Witness \_\_\_\_\_

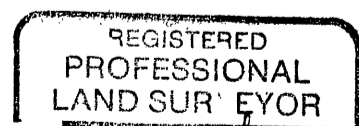

*Mark F. Smalley*

OREGON  
JULY 26, 1988  
MARK F. SMALLEY  
2354

Renews 6/30/02

O.S. File No. 65/37-28