

FILED

Date: 10-24-2001 By: SC

This survey consists of:

Map: _____

Narrative: _____

Corner Rpt: CS 65/37-29

OREGON CORNER RESTORATION FORM

Section 16 Township 31S Range 4W

County DOUGLAS Date 3-29-00

DOUGLAS COUNTY
SURVEYOR

Corner Designation
400400

S16/S15
S21/S22

- Condition Report Only
- Not Found
- Renewed
- Unrecorded
- Surveyed In
- Referenced Out

Previous Renewals/Surveys, etc. _____

Monument(s) & Accessories Found: (Condition and Source)

- 1966 DCSO IPBC LEANS NORTH
- 1893 52" FIR N75W 73° FAIR-HEALED FACE (ORIGINAL)
- 1893 FIR STUMP S57W 18° (ORIGINAL)
- 1893 32" FIR N34½E 27° GOOD-HEALED FACE (ORIGINAL)
- 1966 41" FIR N88E 18° GOOD-HEALED FACE

Monument Detail



Sketch

Monument Set (Procedures and Description)


New Accessories

BTS: 2001
15" HEMLOCK N62W 29° SCRIBED "316 BT"

Location & Comments

Compass Declination 20°
 Firm/Agency ROSEBURG FOREST PRODUCTS
 Address PO BOX 1088 ROSEBURG OR 97470
 Party Chief BILL OLSON
 Notes _____
 Witness _____

Surveyor's Seal

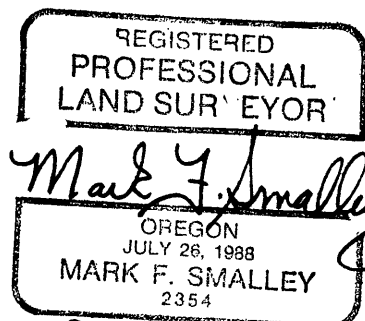

Renews 6/30/02

C.S. File No. 65/37-29