

FILED

Date: 11-28-2001 By: JC

This survey consists of:

Map: \_\_\_\_\_

Narrative: \_\_\_\_\_

Corner Rpt: 65/40-7

OREGON CORNER RESTORATION FORM

Section 12 Township 24S Range 8W

County Douglas Date 11-13-01

DOUGLAS COUNTY  
SURVEYOR

Corner Designation

600500

- Condition Report Only
- Not Found
- Renewed
- Unrecorded
- Surveyed In
- Referenced Out

Previous Renewals/Surveys, etc. \_\_\_\_\_

Monument(s) & Accessories Found: (Condition and Source)

1959 CADASTRAL I.P.B.C.

9" FIR N63W 28<sup>2</sup> GOOD-HEALED (THIS BT WAS TAGGED & SCRIPED IN 1996

14" MADRONE N50<sup>1</sup>2E 9<sup>2</sup> GOOD-HEALED BY ROSEBURG RESOURCES)

22" FIR S43E 52<sup>1</sup> GOOD-HEALED

16" FIR S33<sup>1</sup>2W 27<sup>2</sup> GOOD-HEALED

Monument Detail

Sketch



Monument Set (Procedures and Description)

\_\_\_\_\_  
 \_\_\_\_\_  
 \_\_\_\_\_  
 \_\_\_\_\_


New Accessories

\_\_\_\_\_  
 \_\_\_\_\_  
 \_\_\_\_\_  
 \_\_\_\_\_

Location & Comments

Surveyor's Seal

Compass Declination 20°  
 Firm/Agency ROSEBURG  
RESOURCES COMPANY  
 Address PO Box 1088  
ROSEBURG OR 97470  
 Party Chief Bill Olson  
 Notes \_\_\_\_\_  
 Witness REET ALFRED

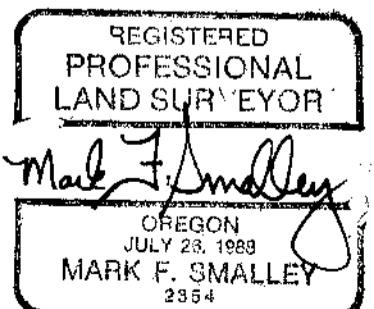

RENEWS 6/30/02

C.S. File No. 65/40-7