

FILED

Date: 2-7-2002 By: JC

This survey consists of:

Map: _____

Narrative: _____

Corner Rpt: 65/42-1

OREGON CORNER RESTORATION FORM

Section 17 Township T25S Range R3W

County DOUGLAS

Date JAN. 11, 2002

DOUGLAS COUNTY
SURVEYOR

Corner Designation

S17 | S16
●
S20 | S21

- Condition Report Only
- Not Found
- Renewed
- Unrecorded
- Surveyed In
- Referenced Out

Previous Renewals/Surveys, etc. _____

COUNTY SURVEYOR - POINT IDENTIFIER # 300400

Monument(s) & Accessories Found: (Condition and Source)

1943 - U.S. GENERAL LAND OFFICE


2" I.P. WITH 2 1/2" BRASS CAP

50" D. FIR STUMP BEARS N29°E 23' (O.B.T.)

20" D. FIR - GOOD CONDITION - BEARS S35°W 15'

Monument Detail

Sketch

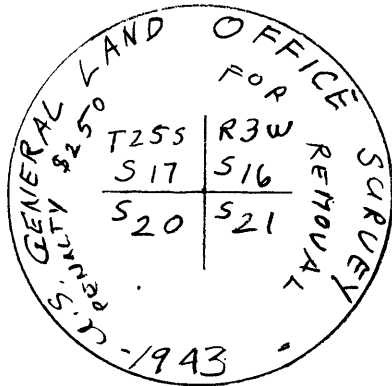

Monument Set (Procedures and Description)

New Accessories

10" D. FIR BEARS N64°E 22° SCRIBED "S16 BT"

9" D. FIR BEARS S41°E 12' SCRIBED "S21 BT"

12" D. FIR BEARS N20°W 7' SCRIBED "S17 BT"

Location & Comments

Surveyor's Seal

Compass Declination 19 1/2°


Firm/Agency ROSEBURG FOREST PRODUCTS

Address OLD HWY 99, DILLARD, OR

Party Chief RALPH McMANIS

Notes _____

Witness _____

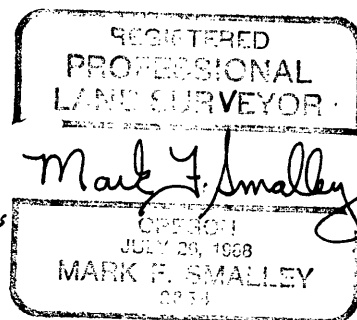

Renews 6/30/02

C.S. File No. 65/42-1