

FILED

Date: 2-7-2002 By: JC

This survey consists of:

Map: _____

Narrative: _____

Corner Rpt: CS 65/42-2

OREGON CORNER RESTORATION FORM

Section 5 Township 25 S Range 7 W

County Douglas Date 10/18/01

DOUGLAS COUNTY
SURVEYOR

Corner Designation

C 1/4 Corner

- Condition Report Only
- Not Found
- Renewed
- Unrecorded
- Surveyed In
- Referenced Out

Previous Renewals/Surveys, etc. 1997 BLM 240640
BLM RECORDS, DCSO Vol. 53, Page 20310.

Monument(s) & Accessories Found: (Condition and Source)

1997 BLM Brass Cap on Iron Pipe
23" Fir bears N 70° E 3.0' Good Condition, Healed Face
23" Fir bears S 18° E 22.1' Good Condition, Scribe Visible

Monument Detail

Sketch

Monument Set (Procedures and Description)

New Accessories

Scribed: 20" White Fir N47°W 31.6' "C 1/4 S BT"
10" Douglas Fir N88°E 29.8' "C 1/4 S BT"

Location & Comments

Surveyor's Seal

Compass Declination 20°

Firm/Agency Roseburg

Forest Products


Address P.O. Box 1088

Roseburg, Oregon 97470

Party Chief Bill Olsen

Notes _____

Witness Bret Alford

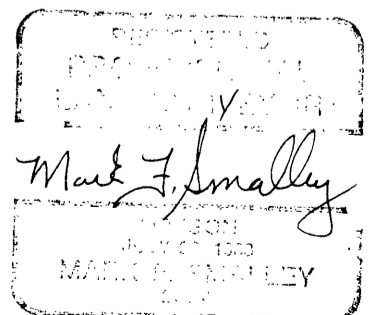

Renews 6/30/02

C.S. File No. 65/42-2