

GARY T. SMITHER

Professional Land Surveyor
Certified Water Rights Examiner

**Township 21 South, Range 8 West
Section 6**

FILED
Date: 2-7-2002 By: JC
This survey consists of:
Map: _____
Narrative: _____
Corner Rpt: 65/42-4

**DOUGLAS COUNTY
SURVEYOR**

East ¼ Corner for Section 6: Found 1945 Brass Cap on Iron Pipe firmly set with steel fence post driven alongside the Brass Cap.

Old Bearing Trees:

1945 36" Fir, S 70° E, 52 links, rotting and burnt with no markings.

1945 40" Fir, N 85° W, 95 links, rotting and burnt with no markings.

14" Fir, no record, S 82° E, 39.0 ft., with visible scribe has fallen over.

9" Fir, no record, N 88 ½ ° E, 25 lks, with healed blaze and 1967 BLM tag.



New Bearing Trees:

16" D. Fir, N 48° W, 16.4 feet to spike driven in side center, marked "T21 R8 1/4 S6 BT", with bearing tree tag.

9" D. Fir, S 54° E, 12.2 feet to spike driven in side center, marked "T21 R8 1/4 S5 BT", with bearing tree tag.

9" D. Fir, N 73° E, 16.1 feet to spike driven in side center, marked "T21 R8 1/4 S5 BT", with bearing tree tag.

Corner Upgrade Jan. 2002

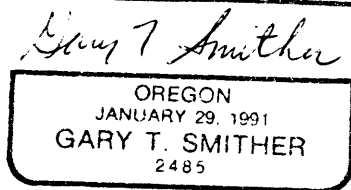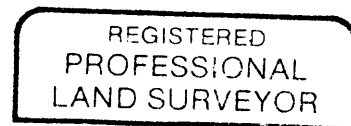

Expires 6/2002