

GARY T. SMITHER

Professional Land Surveyor
Certified Water Rights Examiner

FILED

Date: 2/7/2002 By: JC

This survey consists of:

Map: _____

Narrative: _____

Corner Rpt: 65/42-9

DOUGLAS COUNTY
SURVEYOR

Township 21 South, Range 8 West Section 6

Southeast Corner for Section Six: Found 1945 Brass Cap on Iron Pipe firmly set with a steel fence post driven alongside the Brass Cap.

Old Bearing Trees:

70" burnt Fir snag, N 55 1/2 ° E, 34 links, with visible scribe and tag.

50" burnt Fir stump, S 70 1/4 ° E, 97 links, no markings.

38" burnt Fir stump, S 16 1/4 ° W, 117 links, with faint scribe visible.

46" Fir snag, N 4 3/4 ° W, 114 links, no markings.


21" D. Fir, N 54° W, 67 links, with healed face and tag.

New Bearing Trees:


7" D. Fir, S 38° E, 17.7 feet to spike driven in side center, scribed "T21 R8 S8BT", with bearing tree tag.

12" Alder, S 64° W, 15.0 feet to spike driven in side center, bark scribed "T21 R8 S7BT", with bearing tree tag.

Corner Upgrade Dec 2001

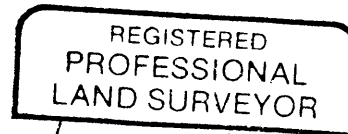

Gary T. Smither

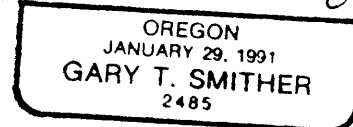

Expires 6/2002