

Corner No. 1

OREGON CORNER RESTORATION FORM

Section 27 Township 32S Range 7W

County Douglas Date March, 2002

Corner Designation

$\frac{1}{4}$ $\frac{527}{534}$

- Condition Report Only
- Not Found
- Renewed
- Unrecorded
- Surveyed In
- Referenced Out

Previous Renewals/Surveys, etc.


Ben Gummy, RLS, set corner in Map 1194-27, 1983.

Monument(s) & Accessories Found: (Condition and Source)

Found 2 1/2" Alum. Pipe with 3" Alum. Cap, from which a:
8" Tan Oak BT, scribes visible, bears N50°W, 5± feet.
16" Douglas Fir BT, face overgrown, bears S3°E, 44±
feet.

Monument Detail

Sketch

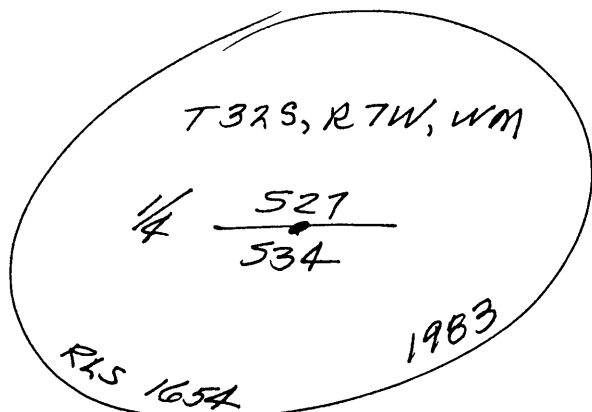

FILED

Date: 3-27-2002 By: JK

This survey consists of:

Map: M137-35

Narrative:

Corner Rpt: 65/42-11 thru 39

**DOUGLAS COUNTY
SURVEYOR**

Monument Set (Procedures and Description)

N/A

New Accessories

Set 6 foot Iron Post, West, 10 feet.

Location & Comments

Corner No. 1

Compass Declination 20E

Firm/Agency Shaner

Engineering

Address P.O. Box 1430

Roseburg, OR 97470

Party Chief B. Shaner

Notes " "

Witness Ben Schneider

Surveyor's Seal

REGISTERED
PROFESSIONAL
LAND SURVEYOR

Bruce A. Shaner

OREGON
OCT. 4, 1957
BRUCE A. SHANER
430

Renewed June 30, 2002

C.S. File No. 65/42-11