

OREGON CORNER RESTORATION FORM

Corner No. 10

Section 27 Township 32S Range TW

County Douglas Date March, 2002

Corner Designation

1/4
527 • 526

- Condition Report Only
- Not Found
- Renewed
- Unrecorded
- Surveyed In
- Referenced Out

Previous Renewals/Surveys, etc. _____

RLS Gimby set corner, Map No. M94-27, in 1983.

Monument(s) & Accessories Found: (Condition and Source)

Found 2 1/2" Alum. Pipe with 2 1/2" Alum. Cap, from which a:

56" Ponderosa Pine BT, original BT, burned out face,
bears S63°W, 97 ± feet.


28" Ponderosa Pine, original BT, now short snag, bears
N27°E, 58 ± feet. I rescribed "1/4 526 BT".

6" Sugar Pine BT, new snag, scribes visible, bears S84°W, 28 ± feet.

10" Tan Oak BT, scribes visible, bears S63°E, 6 ± feet.

Monument Detail

Sketch

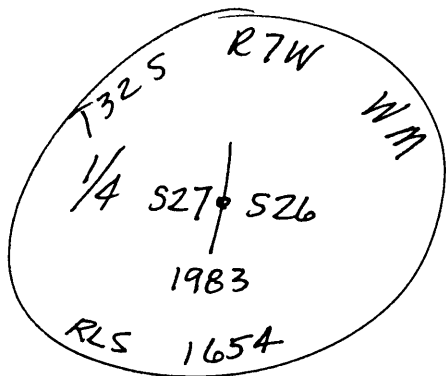

FILED

Date: 3/27/2002 By: JC

This survey consists of:

Map: M137-35

Narrative: _____

Corner Rpt: 65/42-11 thru 39

DOUGLAS COUNTY
SURVEYOR

Monument Set (Procedures and Description)

N/A

New Accessories

12" Madrone BT, I bark scribed "1/4 527 BT"
bears N36°W, 16 ± feet.

Location & Comments

Compass Declination 20°E

Firm/Agency Shaner
Engineering

Address P.O. Box 1430
Roseburg, OR 97470

Party Chief B. Shaner

Notes " "

Witness Ben Schneider

Surveyor's Seal

REGISTERED
PROFESSIONAL
LAND SURVEYOR

Bruce A. Shaner

OREGON
OCT. 4, 1957
BRUCE A. SHANER
430

Renewed June 30,

2002

C.S. File No. 65/42-20