


OREGON CORNER RESTORATION FORM

Section 27 Township 32S Range TW

Corner No. 13

County Douglas Date March, 2002

Corner Designation

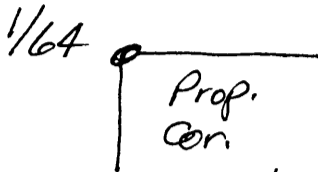

- Condition Report Only
- Not Found
- Renewed
- Unrecorded
- Surveyed In
- Referenced Out

Previous Renewals/Surveys, etc.

RLS Van Swearingen, Map ^M 21-61, in 1961.*

* (We were requested to redo this survey.)

Monument(s) & Accessories ~~Found:~~ Set: (Condition and Source)

I set a 3/4" x 40" Iron Rod with a 2 1/2" Alum. Cap, from which a:
(Position of corner set by V.S. (determined by BT's) bears
N29°W, 3 1/2 feet.)


10" Madrone BT, scribes visible, bears N14°E, 6 1/2 feet.

10" Madrone BT, face overgrown, I rescribed "1/64 BT"
on bark, bears N27°W, 9 3/4 feet.

6 Foot Steel Fence Post, bears West, 10 feet.

Monument Detail

Sketch

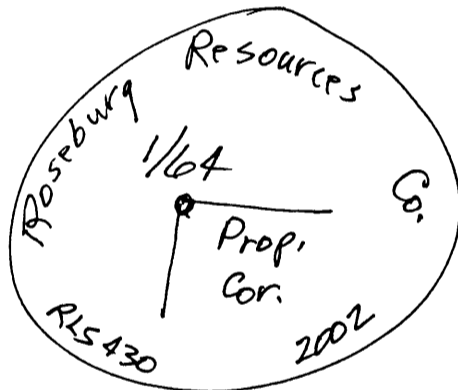

FILED

Date: 3/27/2002 By: X

This survey consists of:

Map: M 137-35

Narrative: _____

Corner Rpt: 65/42-11 thru 39

DOUGLAS COUNTY
SURVEYOR

Monument Set (Procedures and Description)

New Accessories

Location & Comments

Surveyor's Seal

Compass Declination 20°E

Firm/Agency Shaner

Engineering, Inc.

Address P.O. Box 1430

Roseburg, OR 97470

Party Chief B. Shaner

Notes " "

Witness Ron Schneider

REGISTERED
PROFESSIONAL
LAND SURVEYOR

Bruce A. Shaner

OREGON
OCT. 4, 1957
BRUCE A. SHANER
430

Renew June 30,
2002

C.S. File No. 65/42-33