


OREGON CORNER RESTORATION FORM

Section 27 Township 32S Range TW

County Douglas Date March, 2002

Corner No. 14

Corner Designation

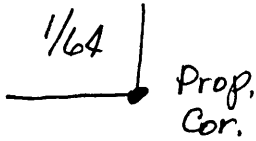

- Condition Report Only
- Not Found
- Renewed
- Unrecorded
- Surveyed In
- Referenced Out

Previous Renewals/Surveys, etc.


RLS Van Swearingen, Map M21-61, in 1961 *
* (We were requested to redo this survey.)

Monument(s) & Accessories ~~Found~~ Set; (Condition and Source)

I set a 3/4" x 40" Iron Rod with a 2 1/2" Alum. Cap,
from which a:
Drill Steel set by V.S., with a 3/4" Pipe alongside,
bears N20°E, 2 1/2 feet.
18" Live Oak BT, with old overgrown face, I bark
scribed "1/64 BT", bears N7°W, 13 1/2 feet.
42" D. Fir BT, I scribed "1/64 BT", bears S28°W, 23 1/2 feet.
6 Foot Steel Fence Post bears West, 1 1/2 feet.

Monument Detail

Sketch

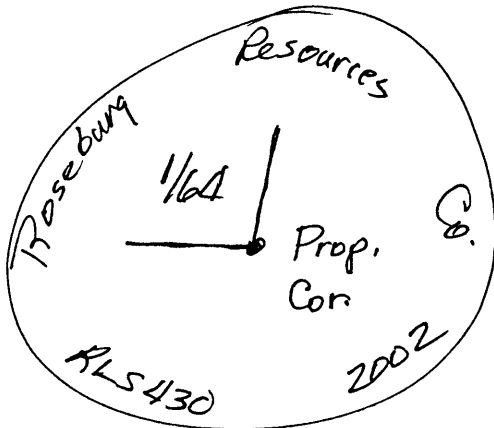

FILED

Date: 3/27/2002 By: JC

This survey consists of:

Map: M137-35

Narrative: _____

Corner Rpt: 65/42-11 thru 39

DOUGLAS COUNTY
SURVEYOR

Monument Set (Procedures and Description)

New Accessories

Location & Comments

Compass Declination 20°E
 Firm/Agency Shaner Engineering, Inc.
 Address P.O. Box 1430
Roseburg, Oregon 97470
 Party Chief B. Shaner
 Notes " "
 Witness Ron Schneider

Surveyor's Seal

REGISTERED
PROFESSIONAL
LAND SURVEYOR

Bruce A. Shaner
 OREGON
 OCT. 4, 1957
 BRUCE A. SHANER
 430

Renews June 30, 2002

C.S. File No. 65/42-24