

OREGON CORNER RESTORATION FORM

Section 27 Township 32S Range 7W

Corner No. 15

County Douglas Date March, 2002

Corner Designation



- Condition Report Only
- Not Found
- Renewed
- Unrecorded
- Surveyed In
- Referenced Out

Previous Renewals/Surveys, etc. _____

This corner was set by unknown surveyor, but possibly RLS Price, circa 1962... We set corrected corner, as below.


Monument(s) & Accessories ~~Found~~ Set: (Condition and Source)

I set a 3/4" x 40" Iron Rod with a 2 1/2" Alum. Cap, from which a:

- 3/4" Iron Pipe, previous property corner, bears N25°E, 40 feet.
- 18" D. Fir BT, I scribed "PCBT", bears N38°E, 14 1/2 feet.
- 8" Tan Oak BT, I scribed "PCBT" bears N61°W, 150 feet.
- 6 Foot Steel Fence post bears West, 10 feet.

Monument Detail

Sketch

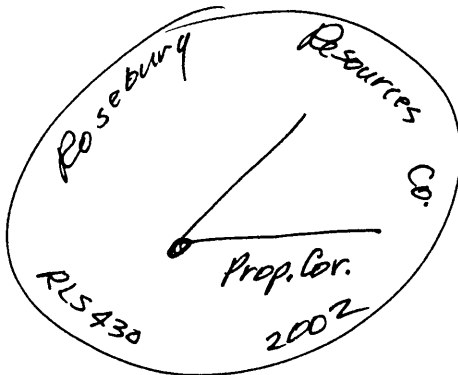

FILED

Date: 3/27/2002 By: JC

This survey consists of:

Map: M 137-35

Narrative: _____

Corner Rpt: 65/42-11 thru 39

DOUGLAS COUNTY SURVEYOR

Monument Set (Procedures and Description)

New Accessories

Location & Comments

Surveyor's Seal

Compass Declination 20°E
 Firm/Agency Shaner Engineering, Inc.
 Address PO Box 1430
Roseburg, Oregon 97470
 Party Chief B. Shaner
 Notes " "
 Witness Ben Schneider

REGISTERED PROFESSIONAL LAND SURVEYOR

Bruce A Shaner

OREGON OCT. 4, 1957 BRUCE A. SHANER 430

Renews June 30, 2002

C.S. File No. 65/42-25