

OREGON CORNER RESTORATION FORM

CORNER No. 16

Section 27 Township 32S Range 7W

County Douglas Date March, 2002

Corner Designation

1/64
|
Prop.
Cor.

- Condition Report Only
- Not Found
- Renewed
- Unrecorded
- Surveyed In
- Referenced Out

Previous Renewals/Surveys, etc.

RLS Van Swearingen, Map M21-61, in 1961.*

* (We were requested to redo this survey)

Monument(s) & Accessories Found: (Condition and Source)

Set


I set a 3/4" x 40" Iron Rod with a 2 1/2" Alum. Cap, from which a:
12" Tan Oak BT with old face, I scribed on bark "1/64 BT",
bears N58°E, 15.6 feet.

10" Tan Oak BT with old face, I scribed "1/64 BT"
bears S62°W, 23.5 feet.

6 Feet Steel Post bears West, 10 feet.

Monument Detail

Sketch

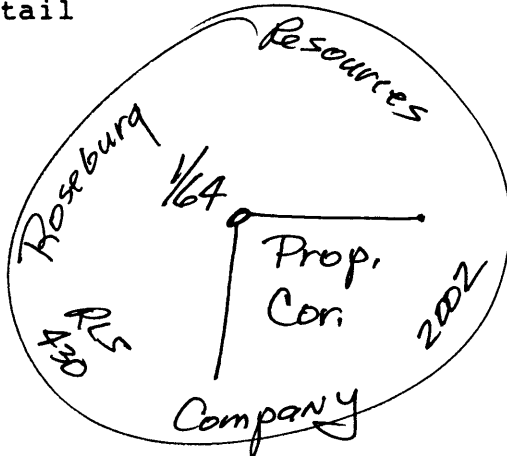

FILED

Date: 3/27/2002 By: JC

This survey consists of:

Map: M137-35

Narrative: _____

Corner Rpt: 65/42-11 thru 39

DOUGLAS COUNTY
SURVEYOR

Monument Set (Procedures and Description)

New Accessories

Location & Comments

V.S. Drill Steel
Corner not found.

Compass Declination 20°E

Firm/Agency Shaner
Engineering

Address P.O. Box 1430

Roseburg, OR 97470

Party Chief B. Shaner

Notes " "

Witness Ben Schneider

Surveyor's Seal

REGISTERED
PROFESSIONAL
LAND SURVEYOR

Bruce A Shaner

OREGON
OCT. 4, 1967
BRUCE A. SHANER
430

Corner Renewed
June 30, 2002
C.S. File No 65/42-26